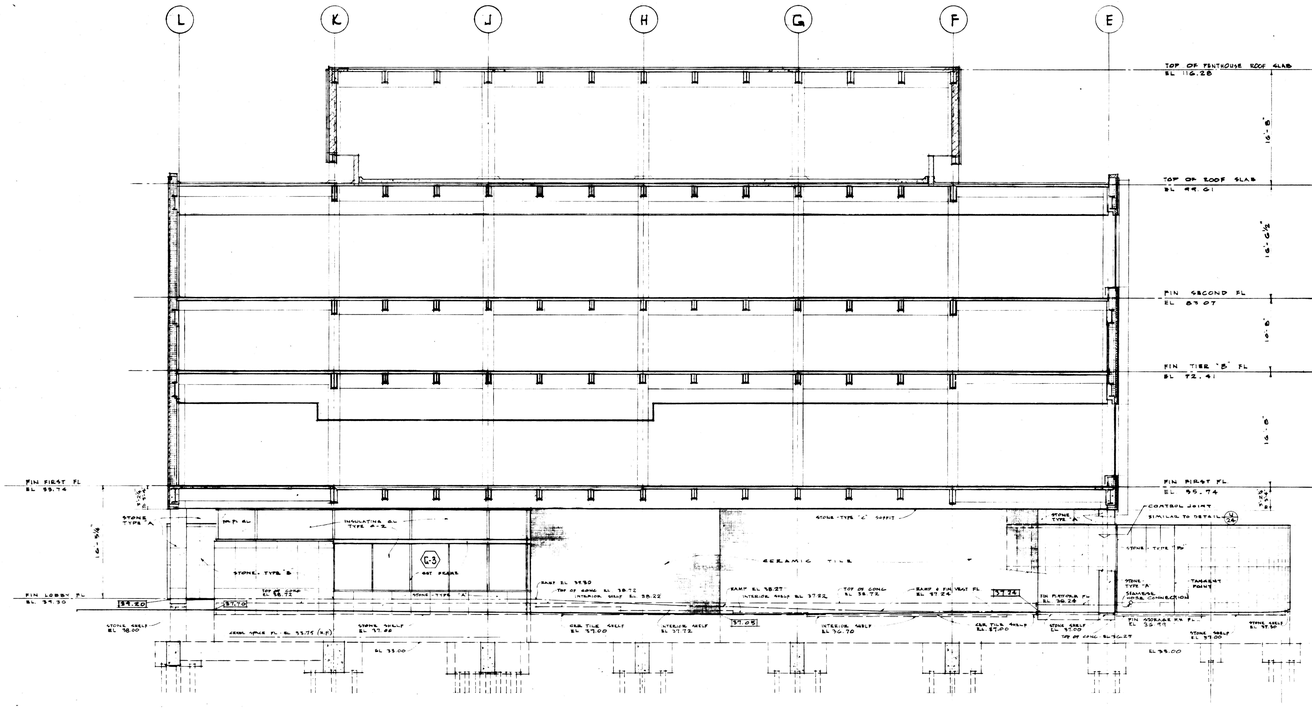

A/7 EAST WALL OF AUDITORIUM & SECTION LOOKING WEST

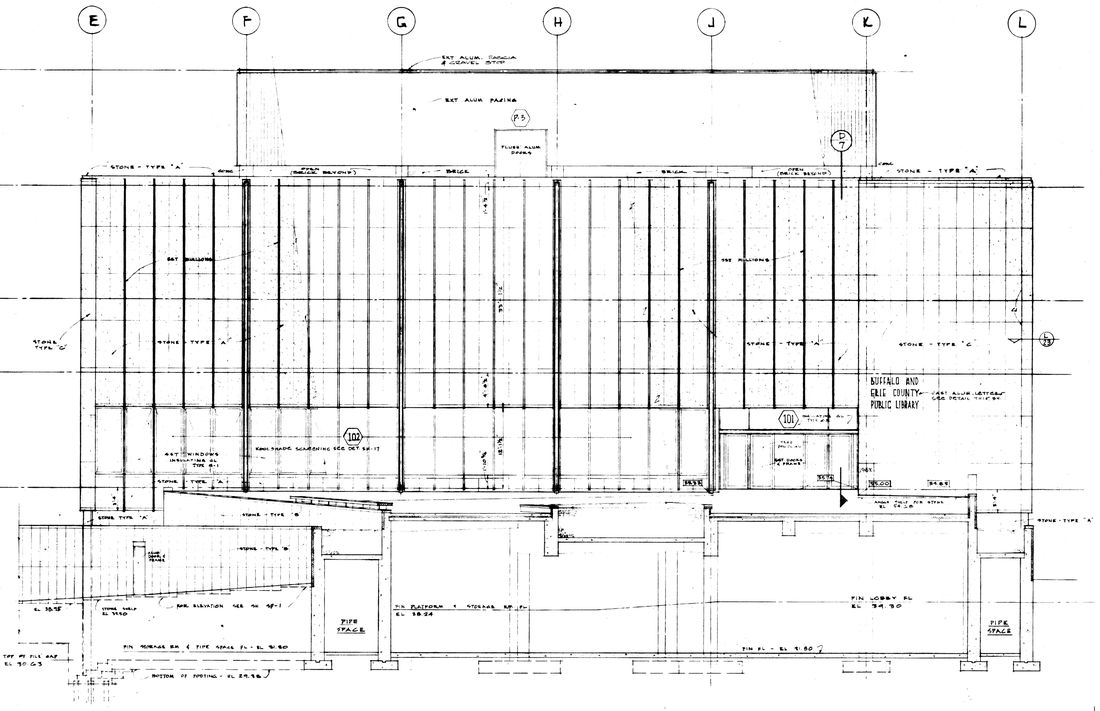

B/7 WEST ELEVATION

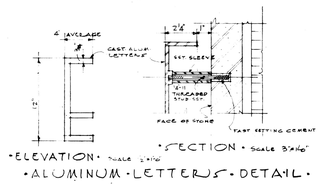

·ELEVATION· SCALE 3"=1'-0"
·SECTION· SCALE 3"=1'-0"
·ALUMINUM·LETTERS·DETAIL·

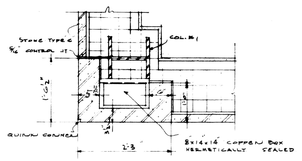

·PLAN·

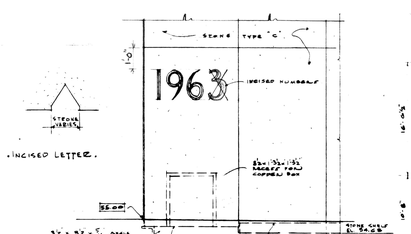

·ELEVATION·

·CORNER·STONE·DETAILS·
SCALE 3"=1'-0"

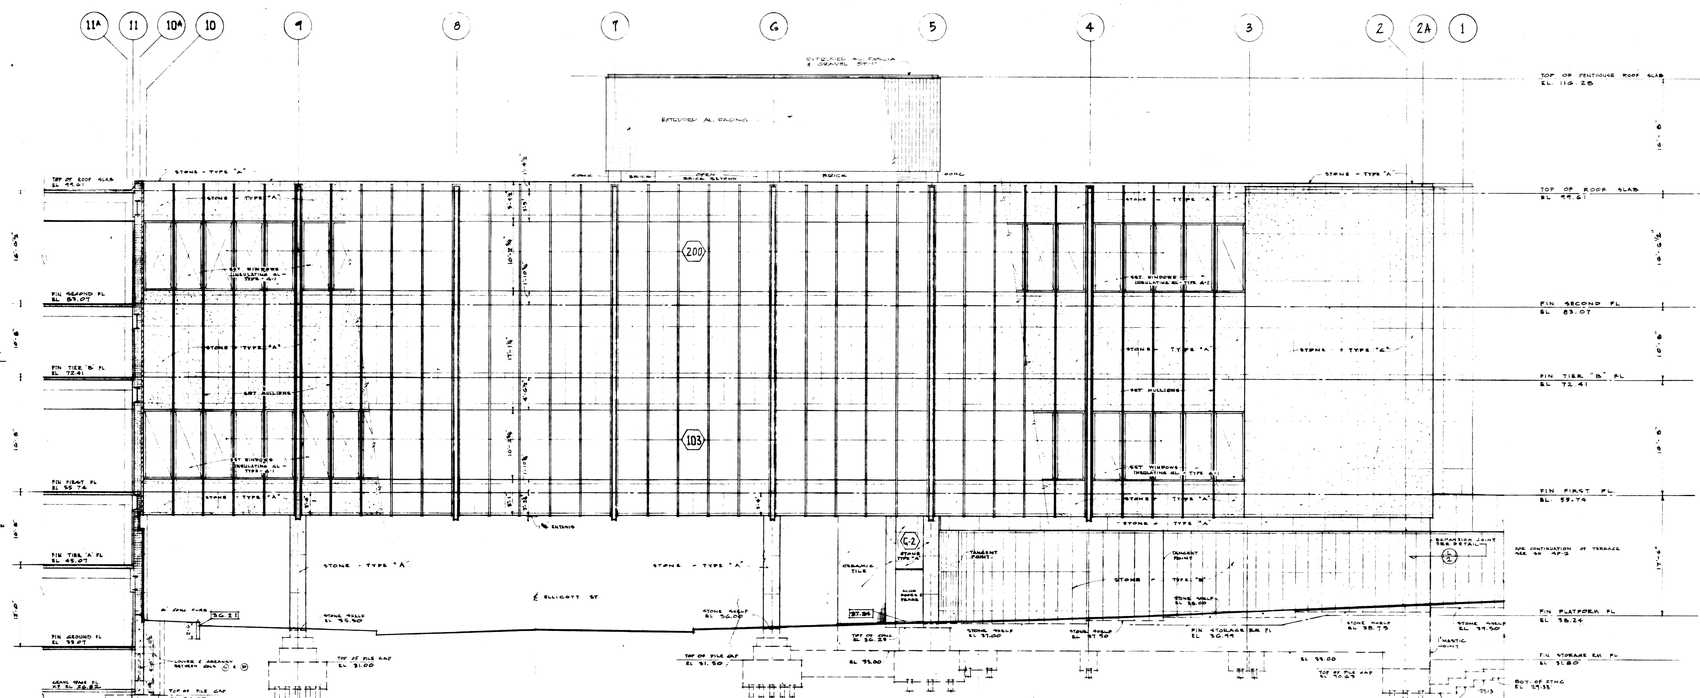

C/7 NORTH ELEVATION

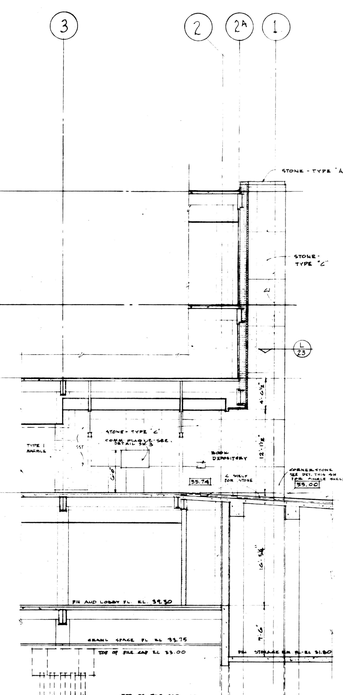

D/7 SECTION

BUFFALO AND ERIE COUNTY PUBLIC LIBRARY

LAFAYETTE SQUARE BUFFALO NEW YORK

JAMES WILLIAM KIDENEY AND ASSOCIATES
PAUL HYDE HARBACH AND ELON B. CLARK JR.
ASSOCIATED ARCHITECTS
220 DELAWARE AVENUE BUFFALO NEW YORK

C. M. MOHRHARDT AND R. A. ULVELING
ASSOCIATED LIBRARY BUILDING CONSULTANTS

JOB NO 6001
DATE 9-19-60
SCALE 1/8"-1'-0"
SHEET NO 7

EXTERIOR ELEVATIONS

812-1960-BECL

12-28-64 AS BUILT DWGS.

COMMERCIAL BLUE PRINT CO., INC., BUFFALO

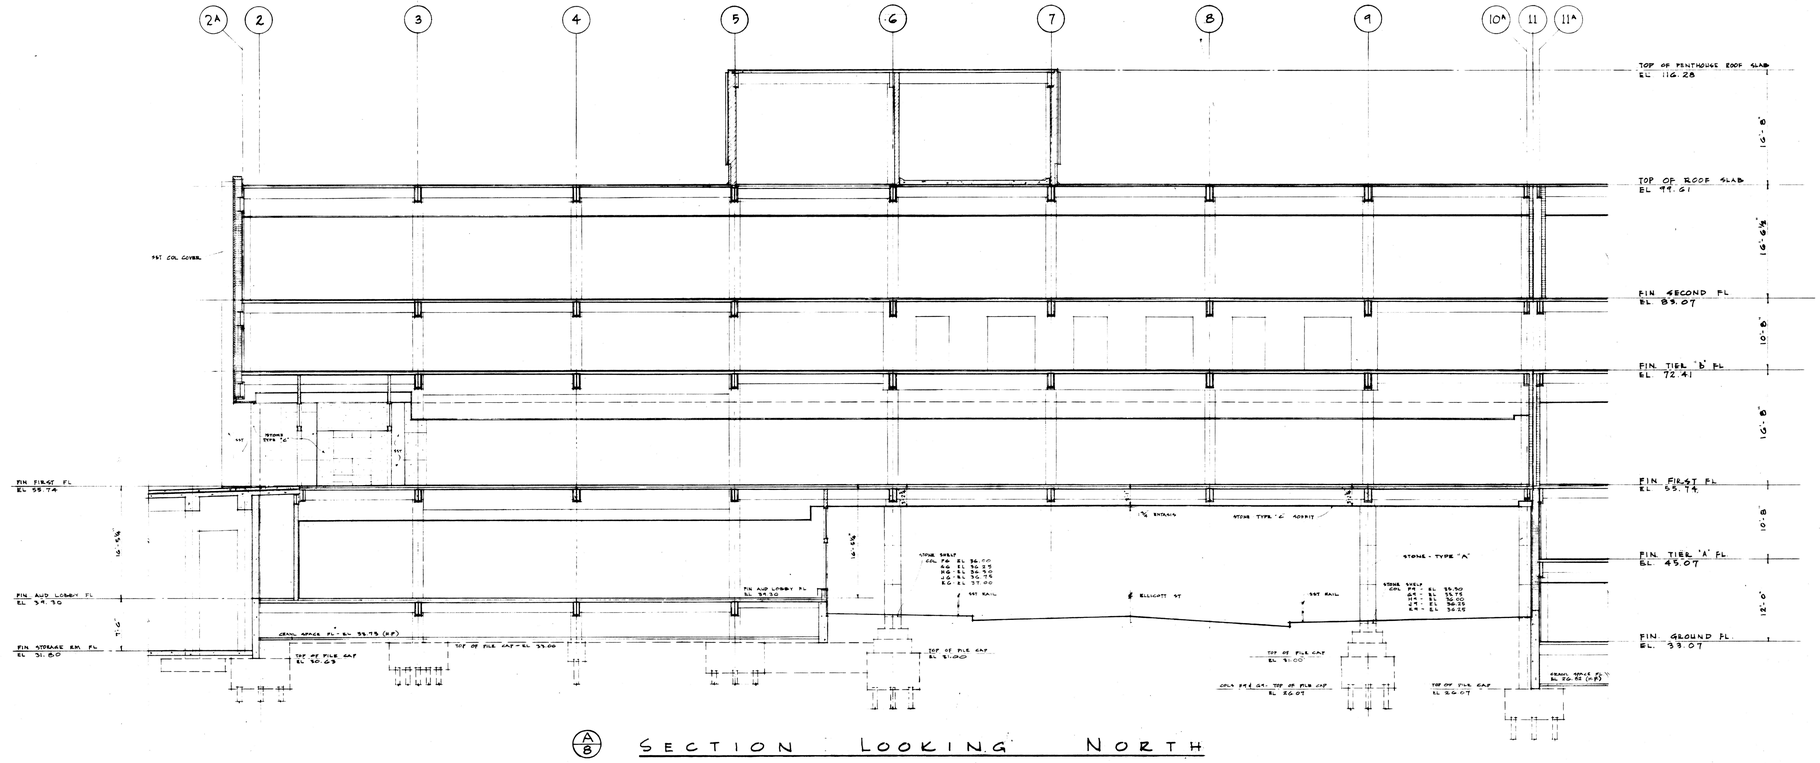

A/B SECTION LOOKING NORTH

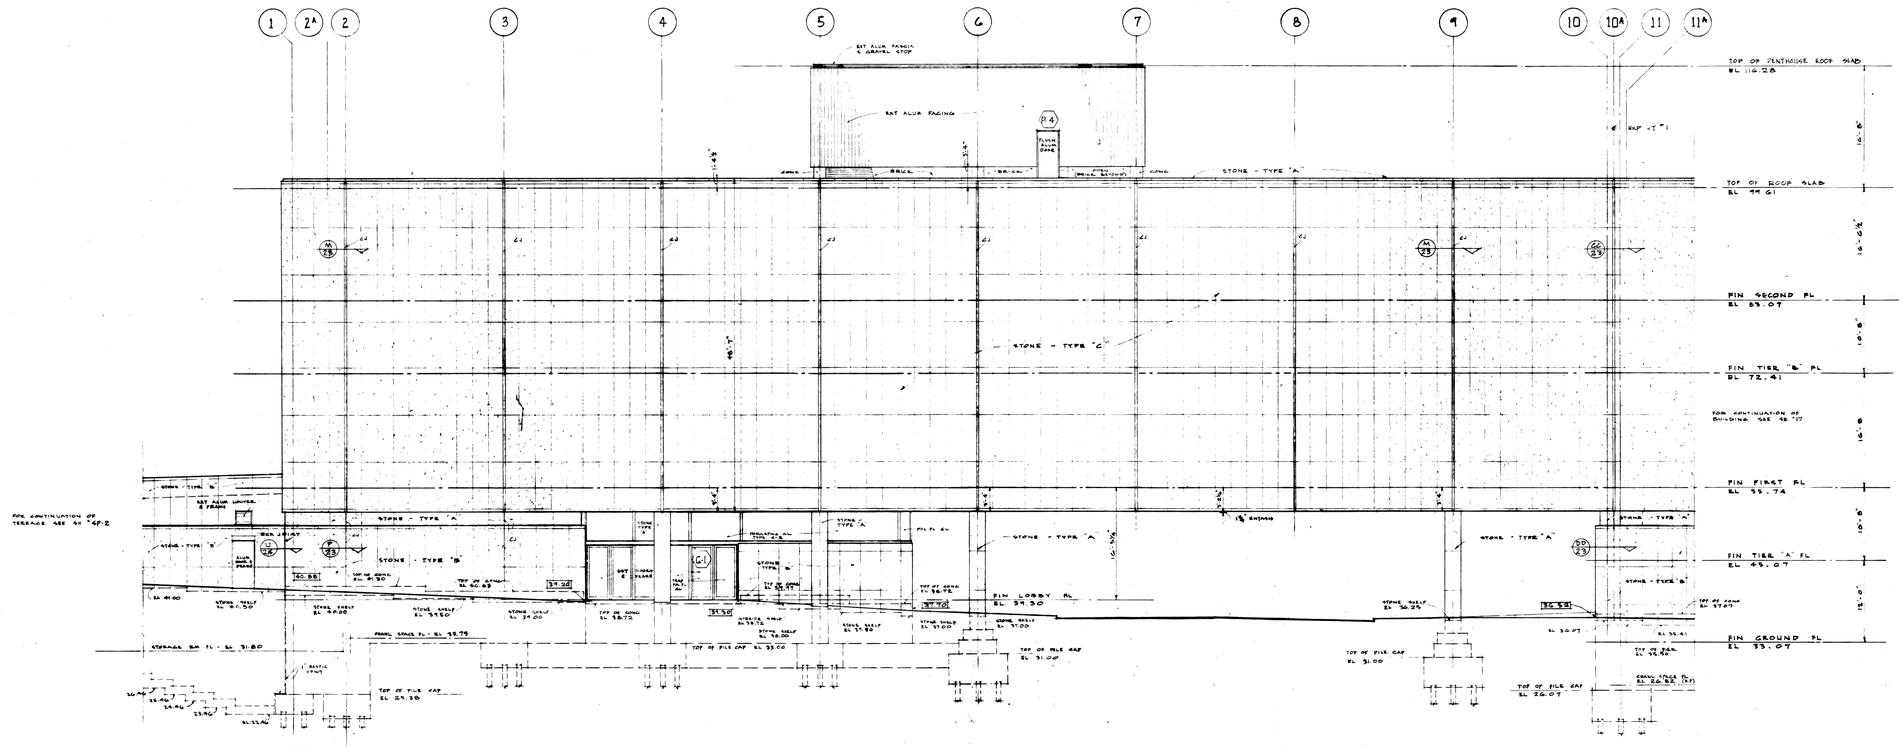

B/B SOUTH ELEVATION

BUFFALO AND ERIE COUNTY PUBLIC LIBRARY

LAFAYETTE SQUARE BUFFALO NEW YORK

JAMES WILLIAM KIDENEY AND ASSOCIATES
PAUL HYDE HARBACH AND ELON B. CLARK JR.
ASSOCIATED ARCHITECTS
220 DELAWARE AVENUE BUFFALO NEW YORK
C. M. MOHRHARDT AND R. A. ULVELING
ASSOCIATED LIBRARY BUILDING CONSULTANTS

JOB NO 6001 SHEET NO 8
DATE 9-19-60
SCALE 1/8"=1'-0"

EXTERIOR ELEVATIONS

812-1960-BECL

12-28-64 As Built Dwgs.

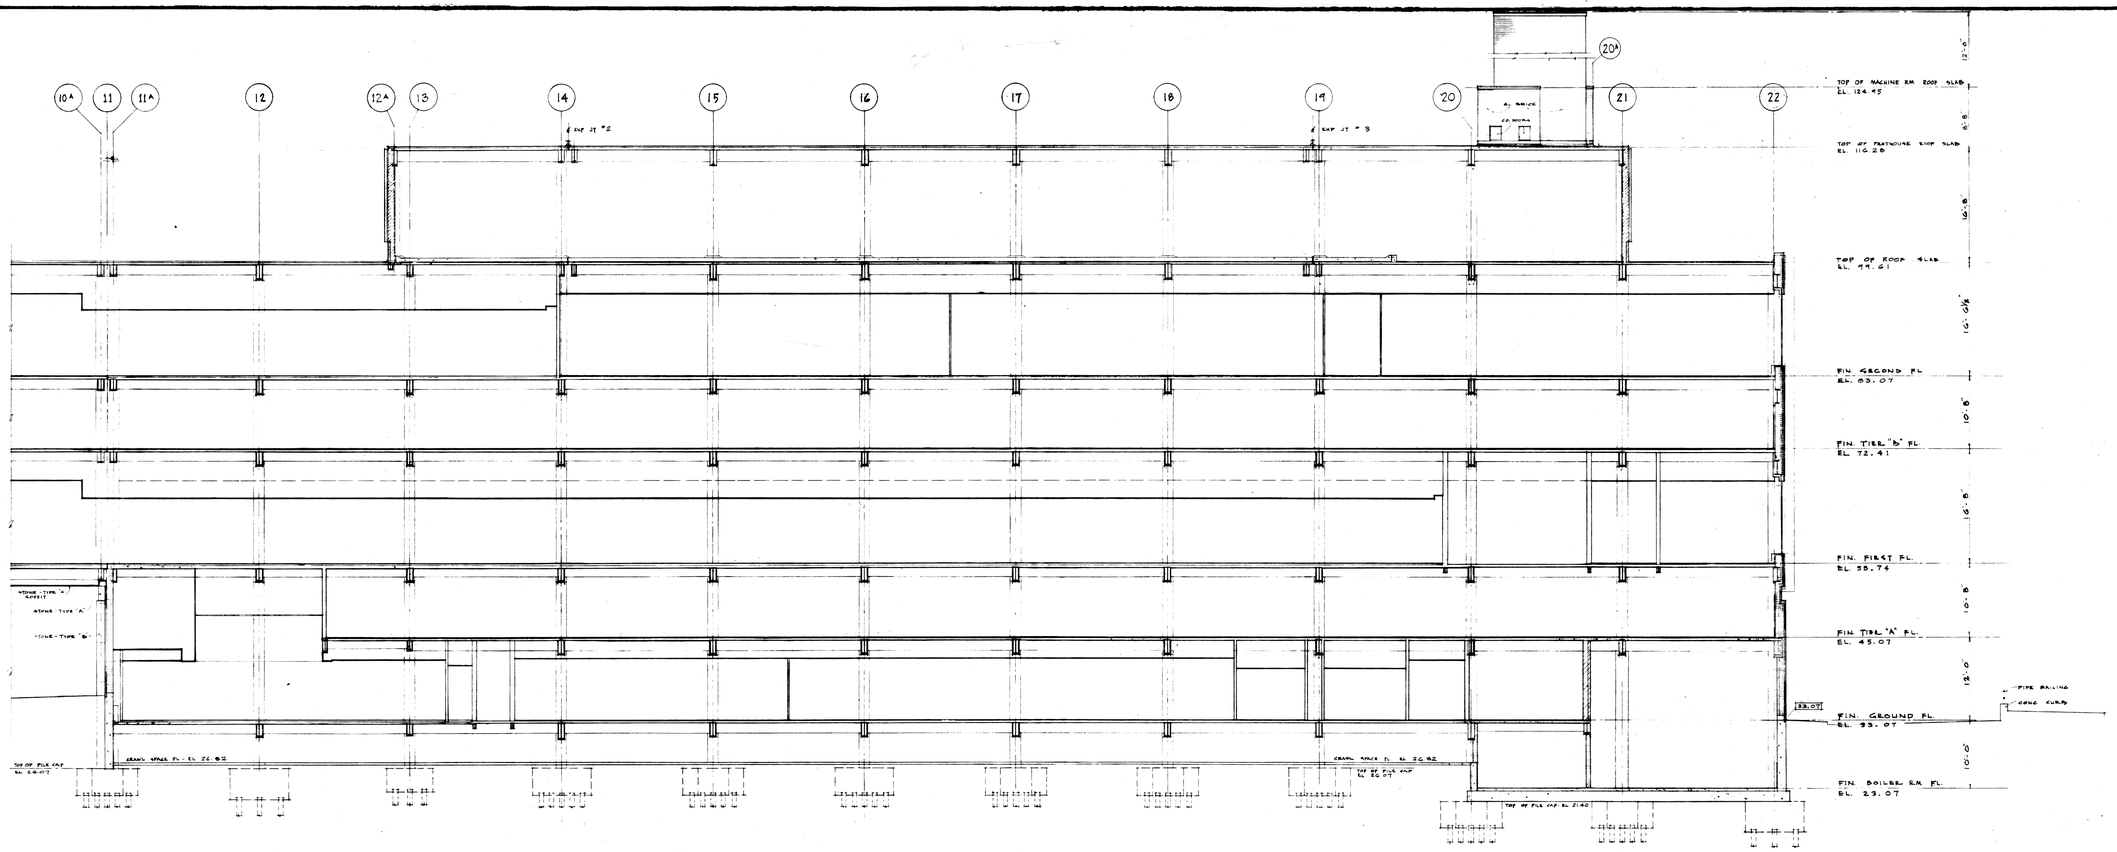

A/17 SECTION LOOKING NORTH

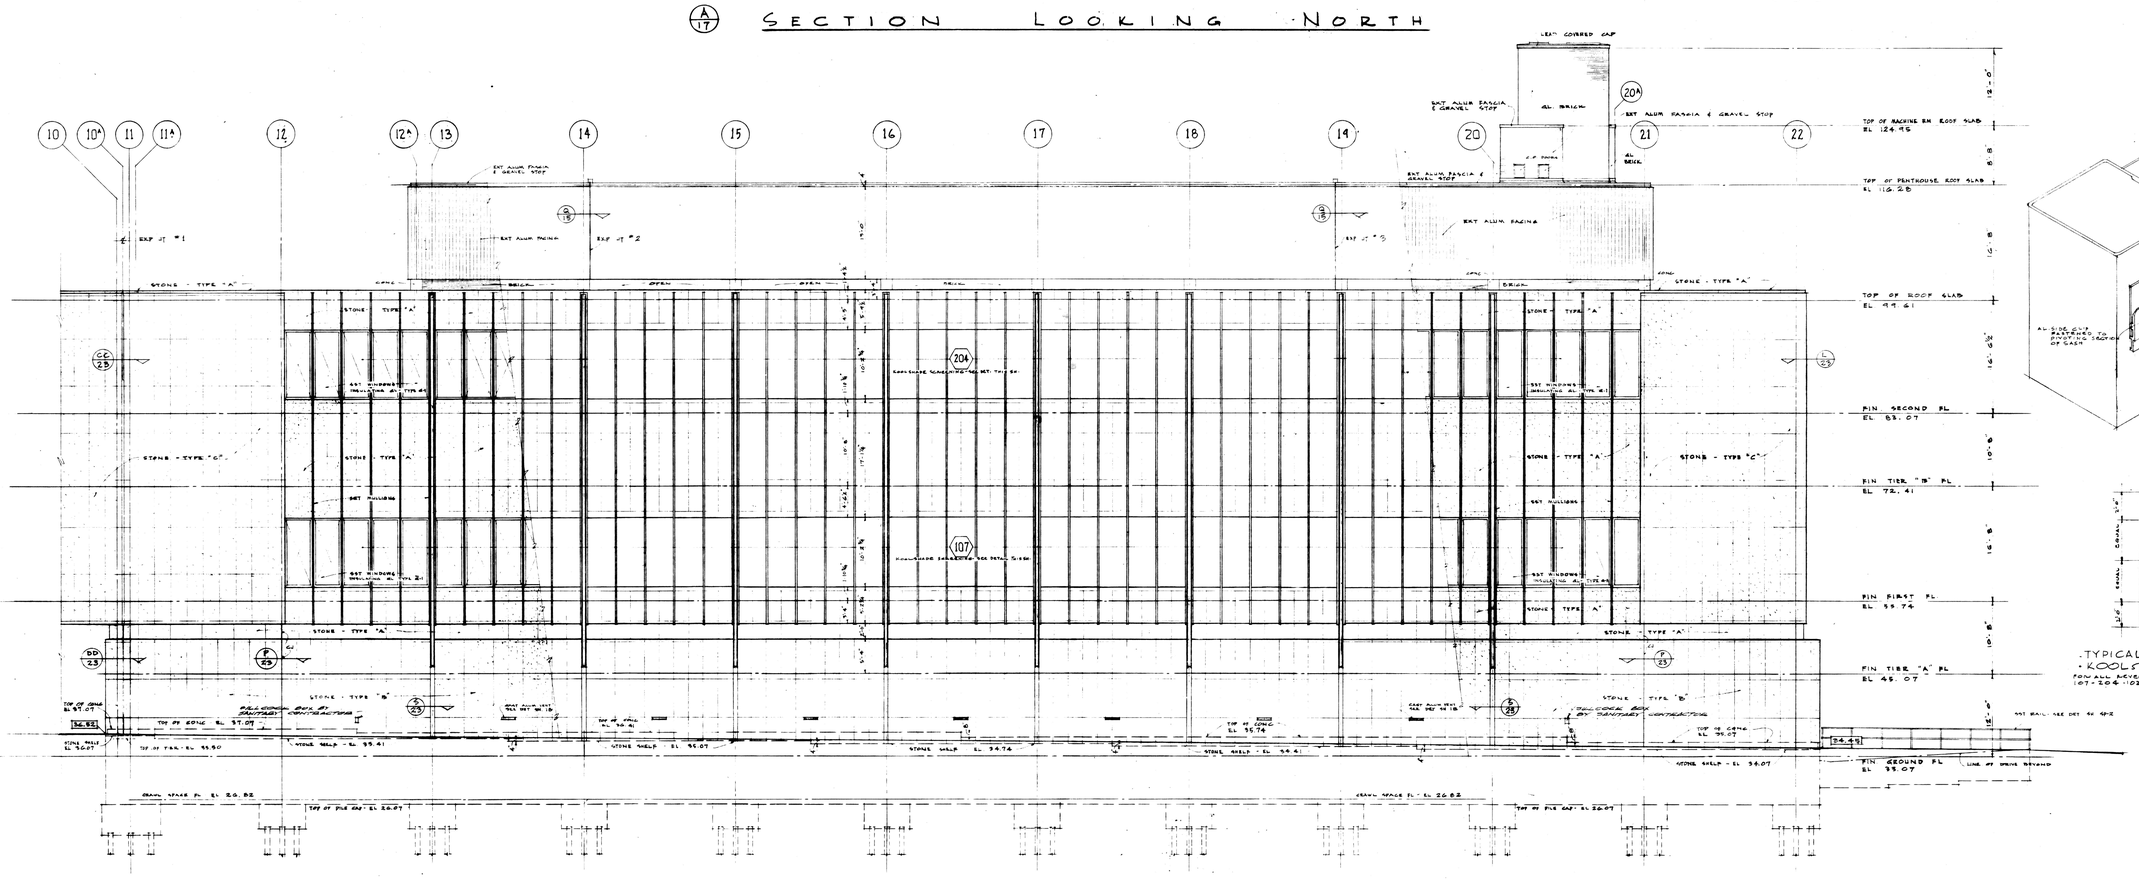

B/17 SOUTH ELEVATION

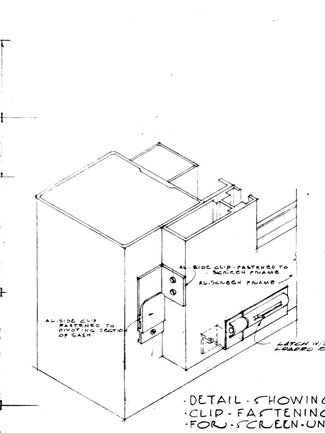

DETAIL SHOWING CLIP FASTENING FOR SCREEN UNITS

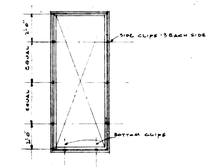

TYPICAL ELEVATION OF KOOLSHADE SCREENING UNIT

FOR ALL SCREENABLE WINDOW UNITS IN OPEN 107-206-102-104-201

NO SCALE

BUFFALO AND ERIE COUNTY PUBLIC LIBRARY

LAFAYETTE SQUARE BUFFALO NEW YORK

JAMES WILLIAM KIDENEY AND ASSOCIATES
PAUL HYDE HARBACH AND ELON B CLARK JR.
ASSOCIATED ARCHITECTS
220 DELAWARE AVENUE BUFFALO NEW YORK

C. M. MOHRHARDT AND R. A. ULVELING
ASSOCIATED LIBRARY BUILDING CONSULTANTS

JOB NO 6001
DATE 9-19-60
SCALE 1/8"-1'-0"

SHEET NO 17

EXTERIOR ELEVATIONS

812-1960-BECL

12-28-64 As Built Dwgs.

COMMERCIAL BLUE PRINT CO., INC., BUFFALO

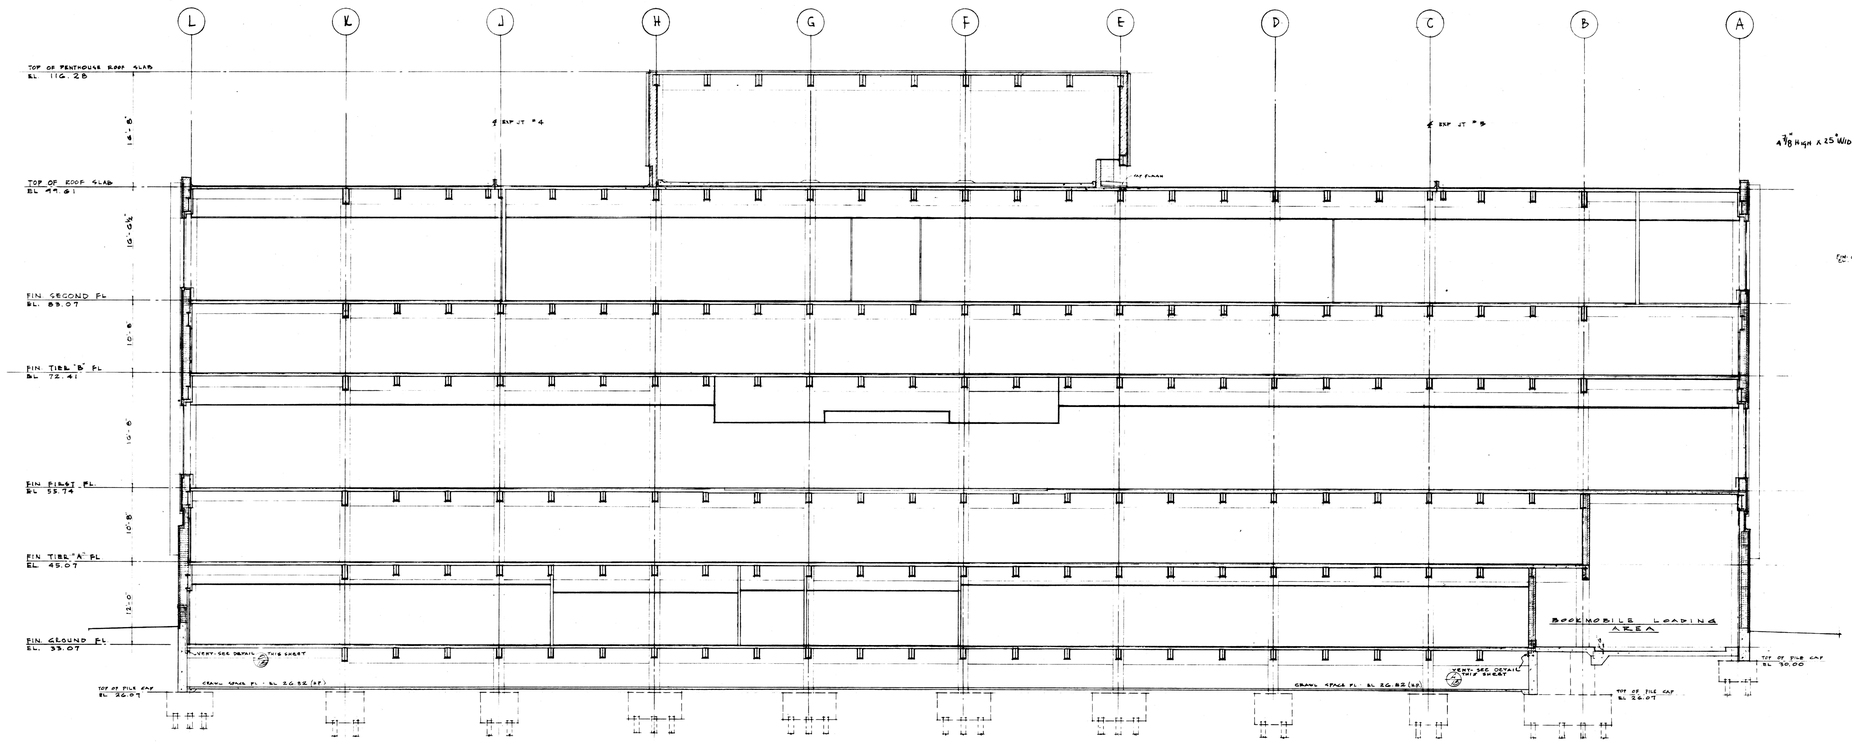

A/18 SECTION LOOKING WEST

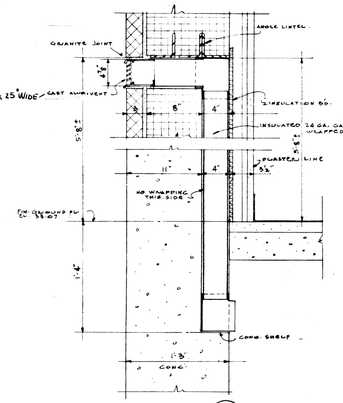

· DETAIL · D/18

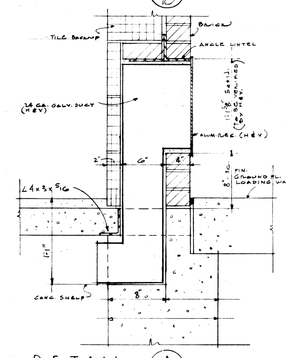

· DETAIL · A/18

· VENT. DETAILS · SCALE 1½"-1'0"

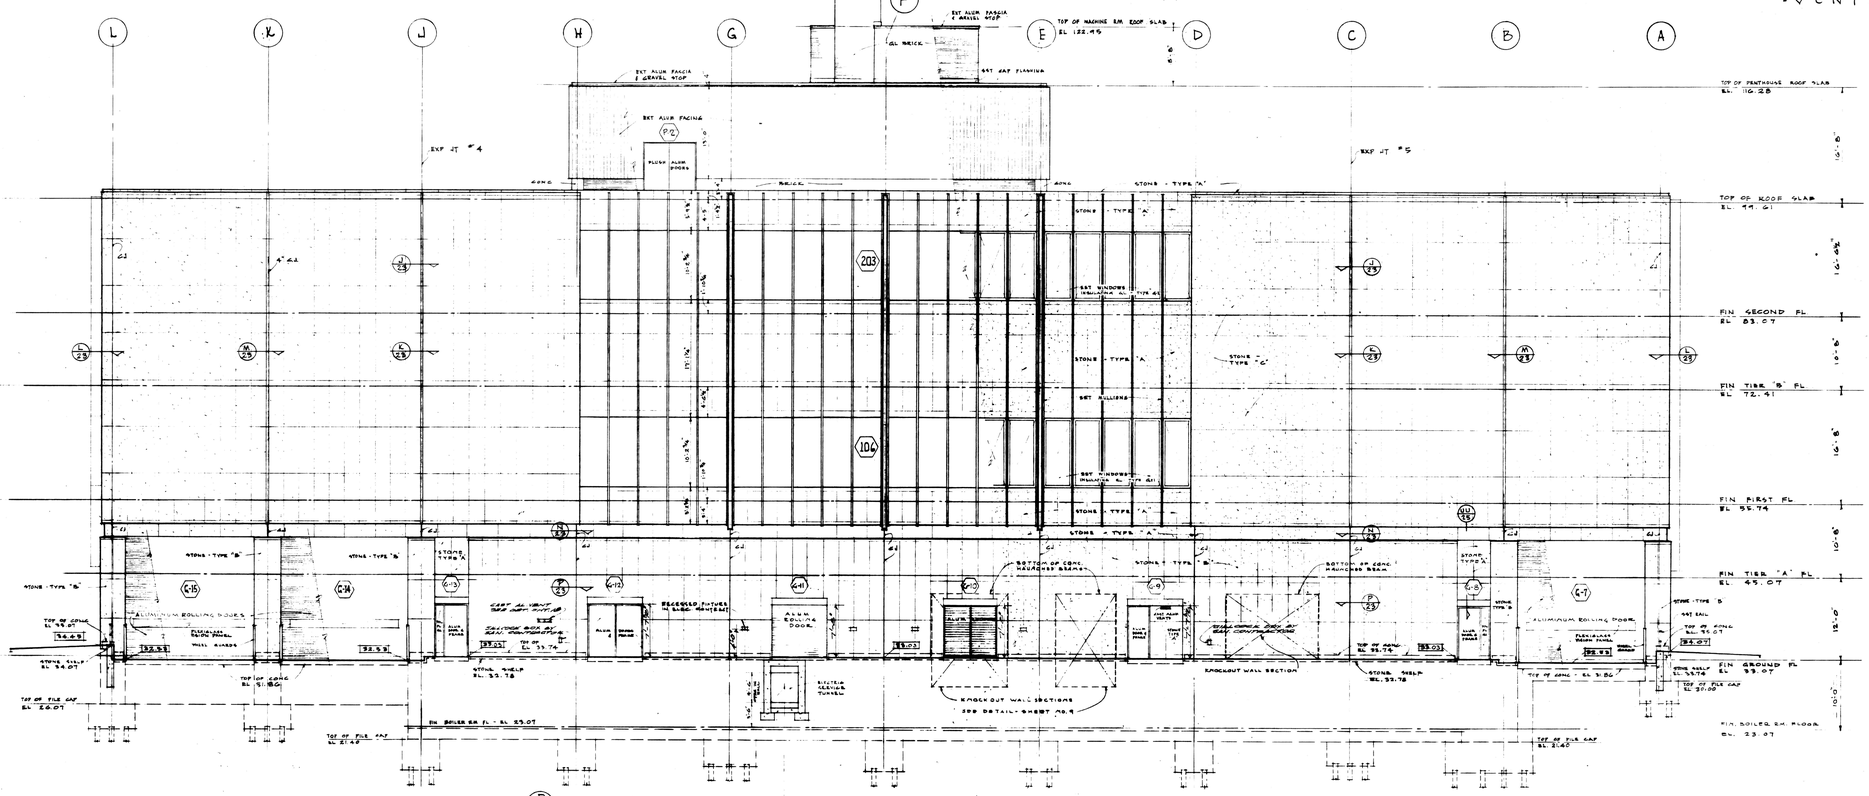

B/18 EAST ELEVATION

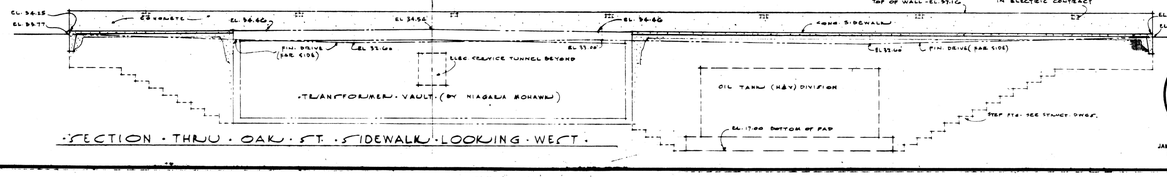

· SECTION · THRU · OAK · ST. · SIDEWALK · LOOKING · WEST ·

BUFFALO AND ERIE COUNTY PUBLIC LIBRARY

LAFAYETTE SQUARE BUFFALO NEW YORK

JAMES WILLIAM KIDENEY AND ASSOCIATES
PAUL HYDE HARBACH AND ELON B. CLARK JR.
ASSOCIATED ARCHITECTS
220 DELAWARE AVENUE BUFFALO NEW YORK
C. M. MOHRHARDT AND R. A. ULVELING
ASSOCIATED LIBRARY BUILDING CONSULTANTS

REGISTERED ARCHITECT UNIVERSITY OF THE STATE OF NEW YORK
JAMES WILLIAM KIDENEY No. 2984
PAUL H. HARBACH No. 1585

JOB NO 6001 SHEET #18
DATE 9-19-60
SCALE 1/8"-1'-0"

EXTERIOR ELEVATIONS

12-28-64 AS BUILT DWGS.

812-1960-BECL

COMMERCIAL BLUE PRINT CO., INC., BUFFALO