

ELEVATION
SCALE 3/4" = 1'-0"

SECTION
SCALE 3/4" = 1'-0"

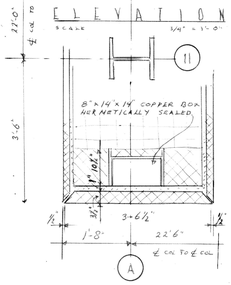

PLAN
SCALE 3/4" = 1'-0"

CORNER STONE DETAIL

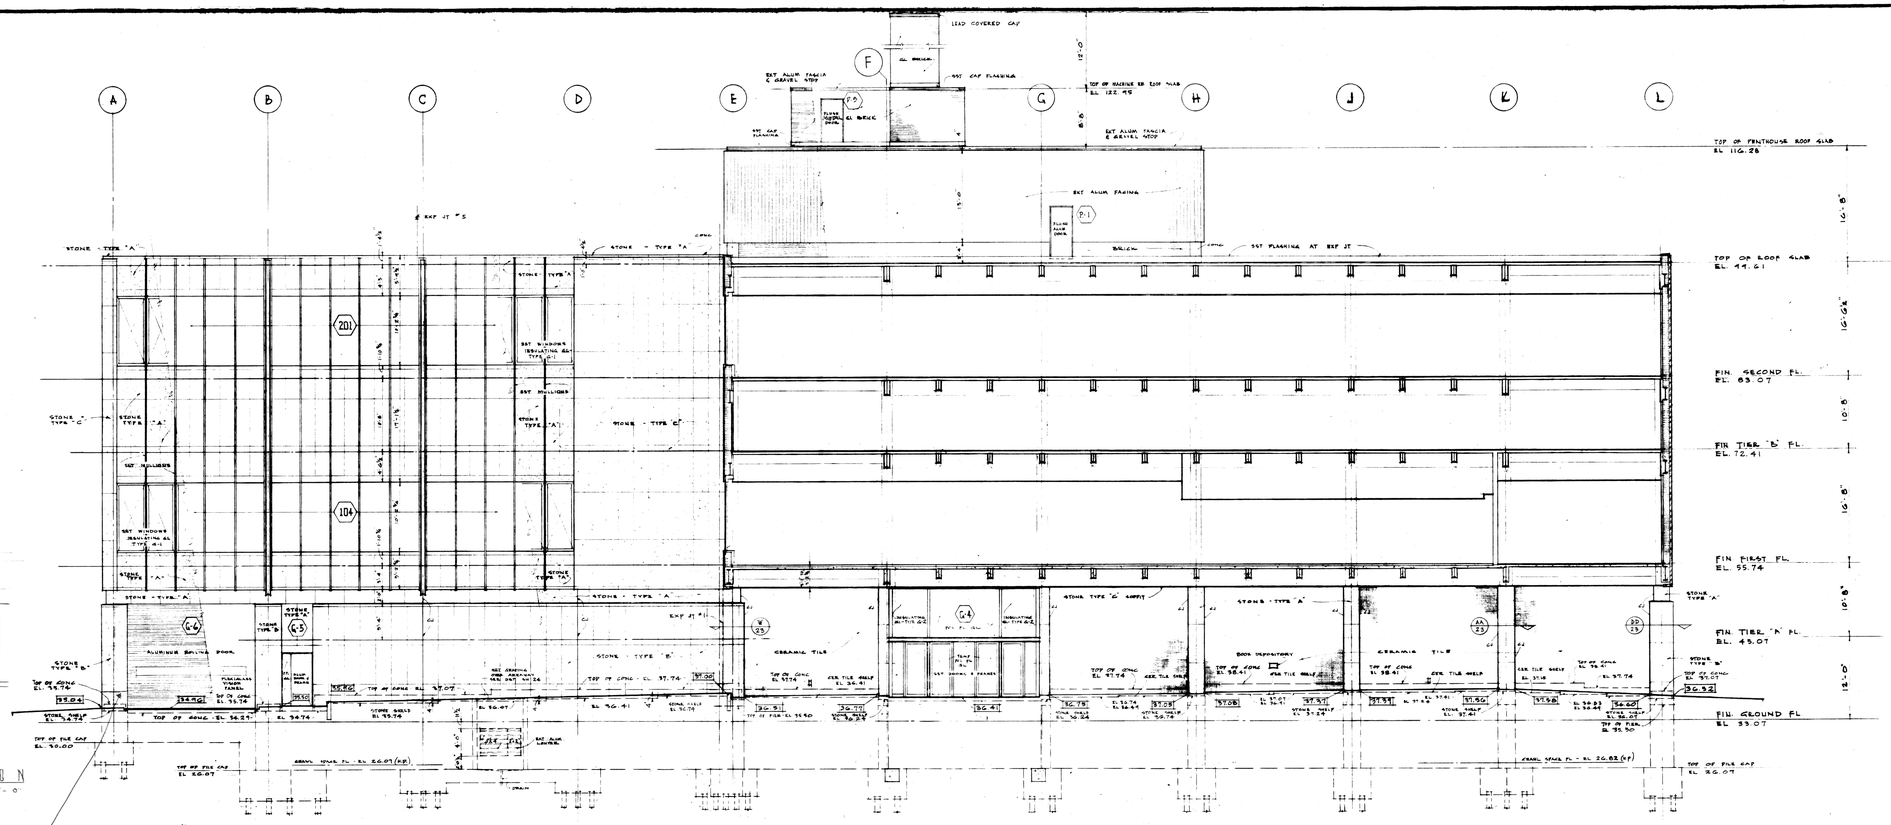

A/19 PARTIAL WEST ELEVATION & SECTION LOOKING EAST

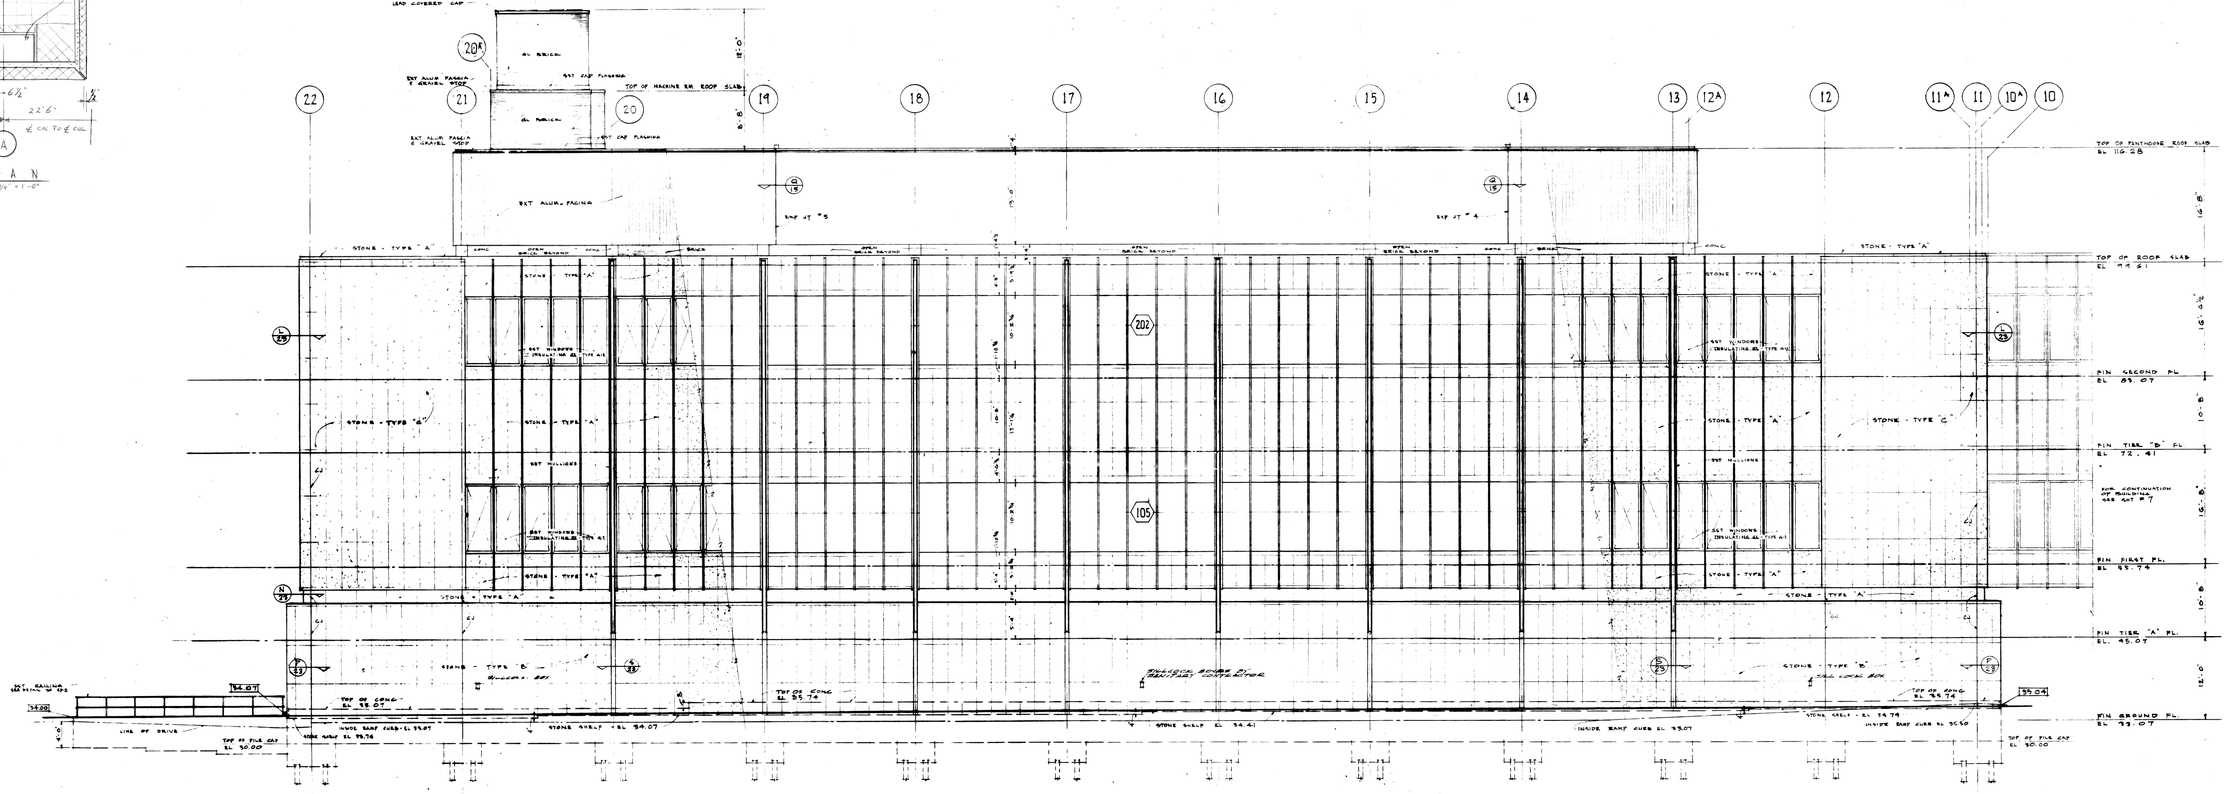

B/19 NORTH ELEVATION

BUFFALO AND ERIE COUNTY PUBLIC LIBRARY

LAFAYETTE SQUARE BUFFALO NEW YORK

JAMES WILLIAM KIDERNEY AND ASSOCIATES
PAUL HYDE HARBACH AND ELON B CLARK JR
ASSOCIATED ARCHITECTS
220 DELAWARE AVENUE BUFFALO NEW YORK

C. M. MOHRHARDT AND R. A. ULVELING
ASSOCIATED LIBRARY BUILDING CONSULTANTS

JOB NO 6001
DATE 9-10-60
SCALE 1/8"-1'-0"

SHEET NO 19

EXTERIOR ELEVATIONS

12-28-64 AS BUILT DWGS.

812-1960-BECL-

COMMERCIAL BLUE PRINT CO., INC., BUFFALO

TOP OF ROOF SLAB

TIER 'B' FLOOR LINE

FIRST FLOOR LINE

ROOF SLAB ELEV. - 99.61'

SECOND FLOOR ELEV. - 83.07'

STACK TIER 'B' ELEV. - 72.41'

FIRST FLOOR ELEV. - 55.74'

GROUND FL. ELEV. - 33.07'

CRAWL SPACE ELEV. - 20.07'

MEETING ROOM 166

STACK ROOM 76-36

STACK TIER 'B'

READING ROOM 150

STACK TIER 'A'

PAINTING G-76

STEEL ROOM 7A-35

STONE TYPE 'A'

STONE TYPE 'B'

STONE TYPE 'C'

WINDOW TYPE G-1

WINDOW TYPE G-2

WINDOW TYPE G-3

WALL SECTION SOUTH WALL OF EAST PORTION OF BUILDING

SCALE: 3/8" = 1'-0"

EAST, WEST AND NORTH WALLS OF EAST PORTION OF BUILDING SIMILAR. SEE 'B' CALCO SECTIONS FOR VARIATIONS.

PARTIAL ELEVATION

SCALE: 3/8" = 1'-0"

PARTIAL PLAN

SCALE: 3/8" = 1'-0"

FOR SPECIFIC LOCATIONS SEE PLANS AND ELEVATIONS.

102 104 106 201 203 103 200

105 107 202 204

TYPICAL COLUMN COVER DETAILS

SCALE: 1½" = 1'-0"

TYPICAL COLUMN COVER AT WINDOW

TYPICAL MULLION

TYPICAL MASONRY JAMB

TYPICAL COLUMN COVER AT SPANDREL FACING MATERIAL

TYPICAL MULLION AT SPANDREL FACING MATERIAL

SIDE VIEW

SECTION

PLAN

COLUMN COVER BRACKET DETAILS (SEE DETAILS THIS SHEET FOR LOCATIONS)

SCALE: 1½" = 1'-0"

MASONRY JAMB AT EXPANSION JOINT

SCALE: 1½" = 1'-0"

NOTES:

ALL STEEL ANGLES, CLIP ANGLES AND PLATES SHOWN AS FACING MATERIAL FOR MULLIONS, COLUMN COVERS AND MET. WINDOW SUBSTRATE (EXCEPT AT MASONRY PARTITION) SHALL BE SECURELY ANCHORED TO MET. WINDOW SUBSTRATE AND HORIZONTAL CONNECTION FOR EACH MULLION SHALL BE WELDED TO MULLION.

ALL SHT. METAL FLASHING, COVERING, CAULKING AND SEALANT SHALL BE INSTALLED IN ACCORDANCE WITH THE RECOMMENDATIONS AND SPECIFICATIONS OF THE SHEET METAL AND AIR CONDITIONING CONTRACTORS NATIONAL ASSOCIATION, INC.

BUFFALO AND ERIE COUNTY PUBLIC LIBRARY

LAFAYETTE SQUARE BUFFALO NEW YORK

JAMES WILLIAM KIDENEY AND ASSOCIATES
PAUL HYDE HARBACH AND ELON B CLARK JR
ASSOCIATED ARCHITECTS
220 DELAWARE AVENUE BUFFALO NEW YORK

C. M. MOHRHARDT AND R. A. ULVELING
ASSOCIATED LIBRARY BUILDING CONSULTANTS

JOB NO 6001 SHEET NO 22
DATE 9-19-60
SCALE AS NOTED

EXTERIOR DETAILS

812-1960-BECL

12-22-64 As Built, Dwgs.

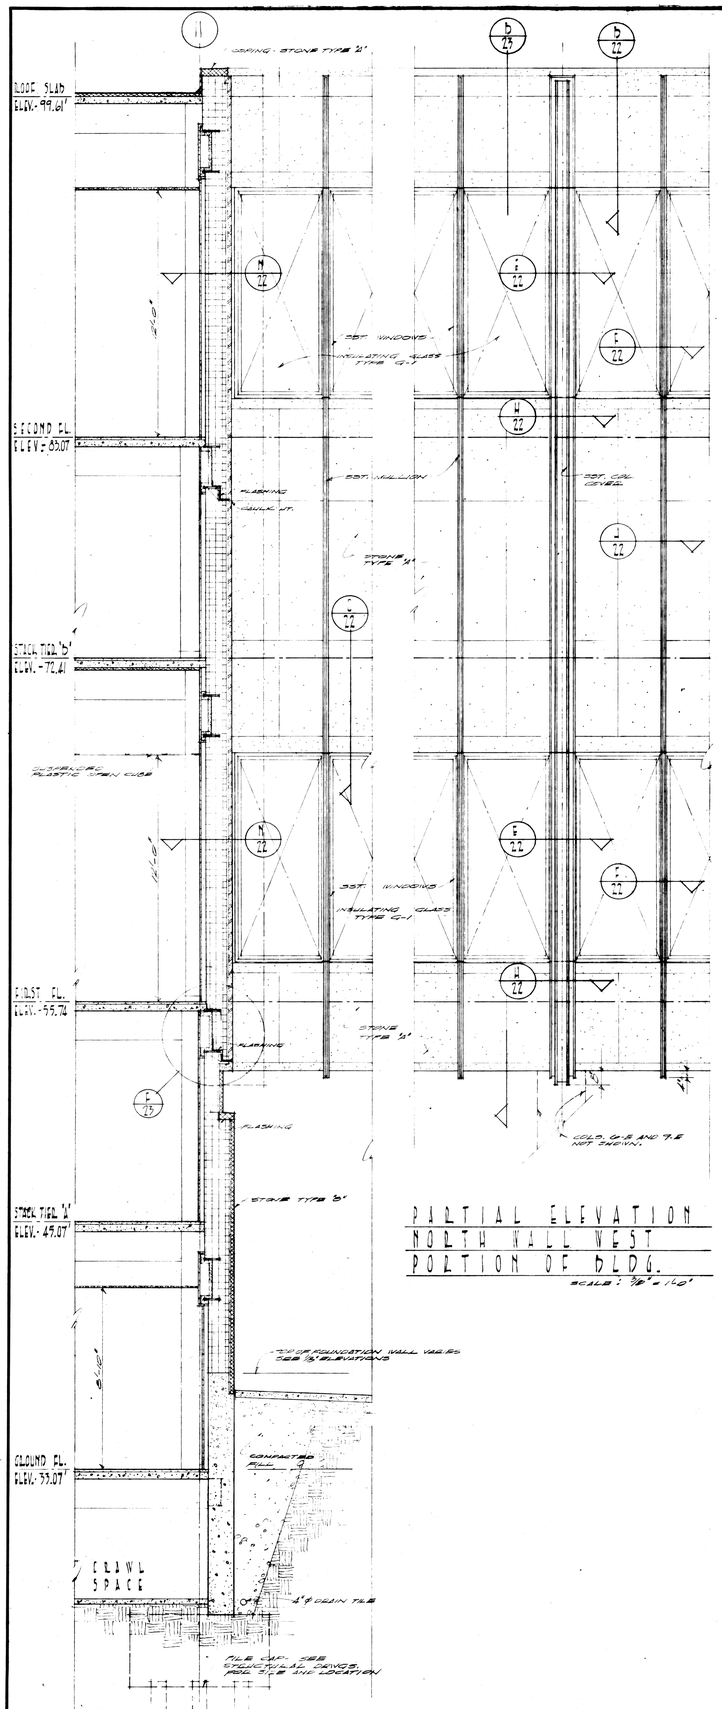

PARTIAL ELEVATION
NORTH WALL WEST
PORTION OF BLDG.
SCALE: 3/8" = 1'-0"

A/23 SECTION THRU
WEST WALL OF EAST
PORTION OF BLDG.
SCALE: 3/8" = 1'-0"

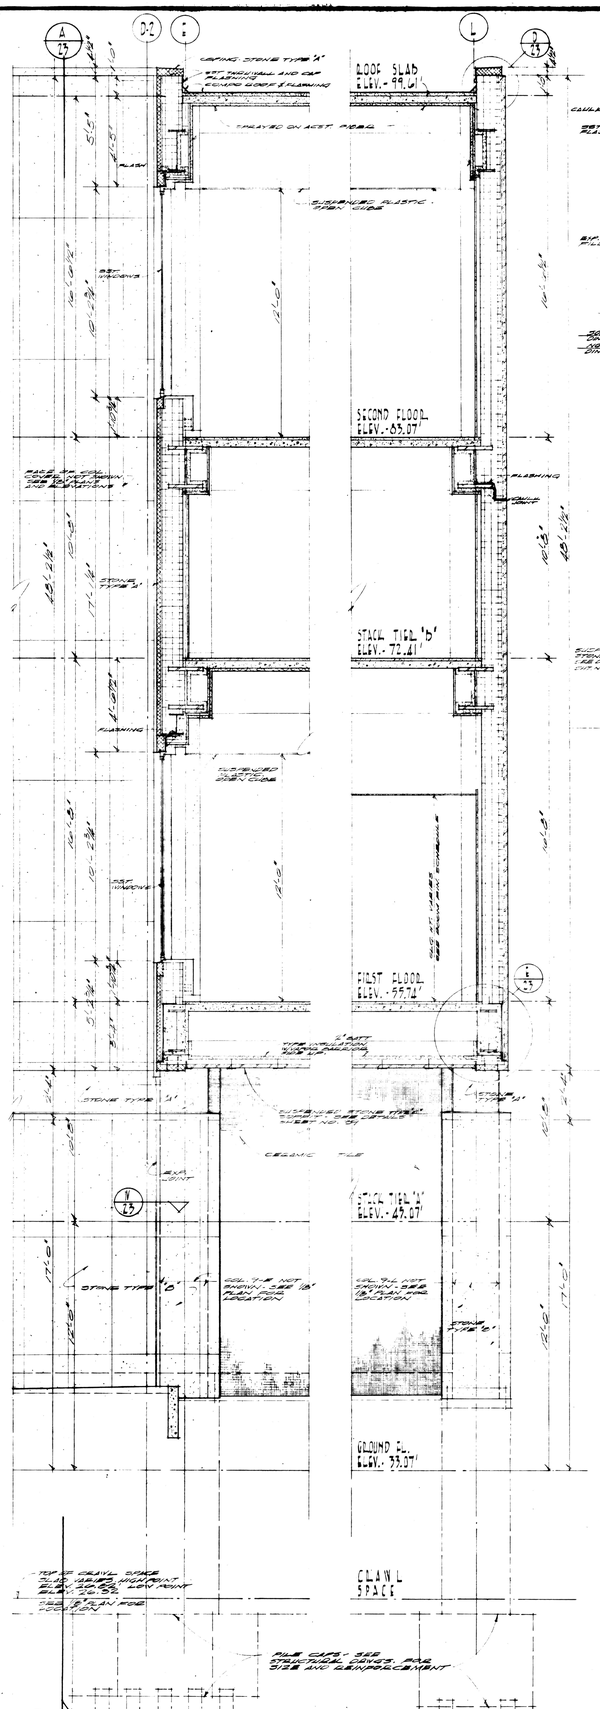

B/23 SECTION THRU
NORTH WALL OVER
ELLICOTT ST.
SCALE: 3/8" = 1'-0"

C/23 SECTION THRU
SOUTH WALL OVER
ELLICOTT ST.
SCALE: 3/8" = 1'-0"

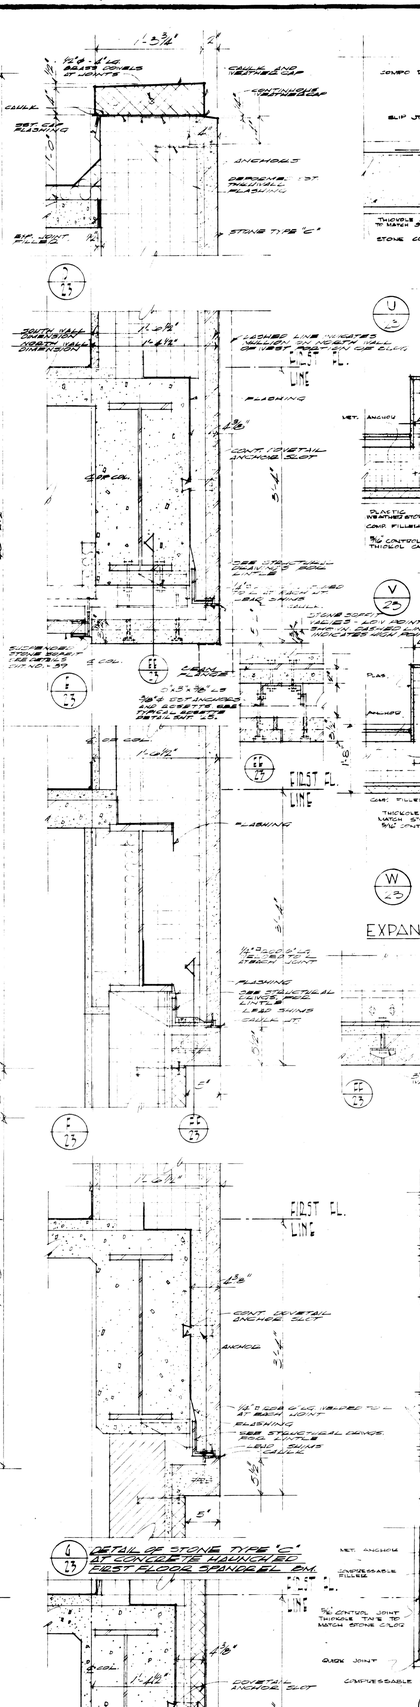

D/23 DETAIL OF STONE TYPE 'C'
AT CONCRETE HAUNCH EL.
FIRST FLOOR SLAB EL.

E/23 DETAIL OF STONE TYPE 'A'
AT CONCRETE HAUNCHED
FIRST FLOOR SLAB EL.

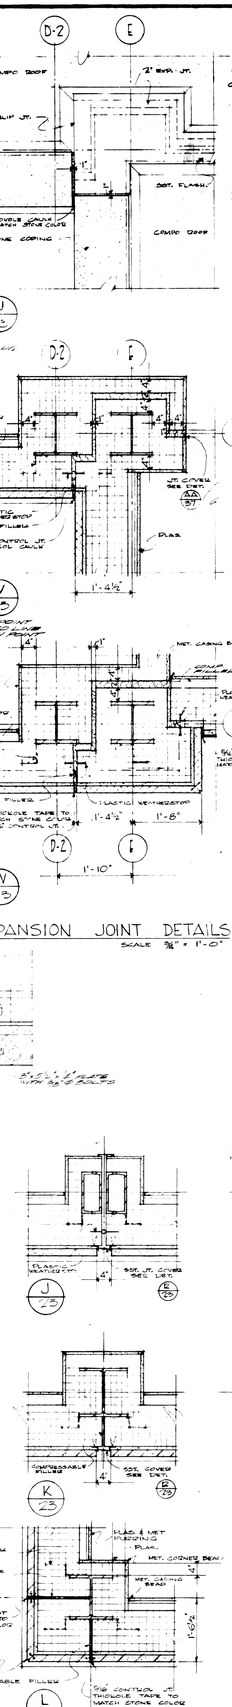

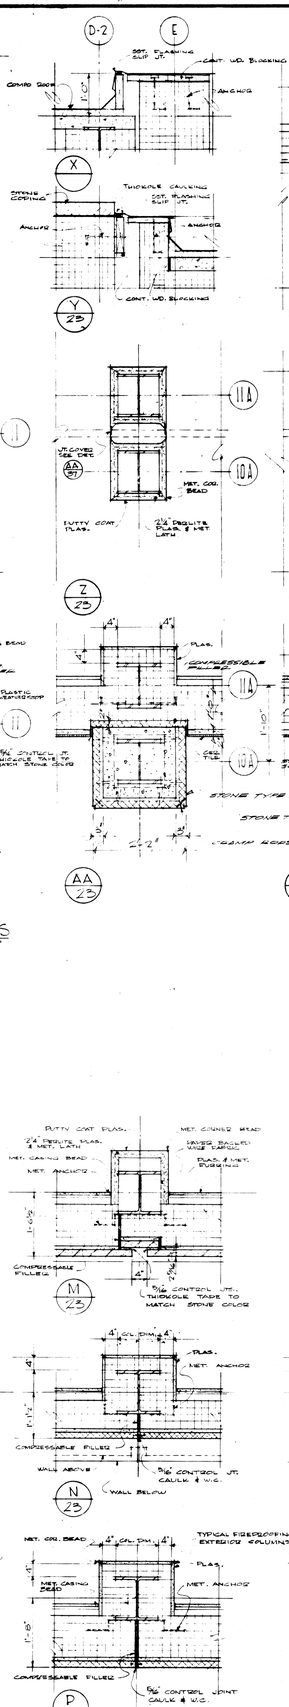

EXPANSION JOINT DETAILS
SCALE ⅜" = 1'-0"

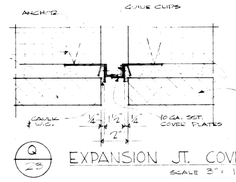

Q/23 EXPANSION JT. COVER
SCALE 3" = 1'-0"

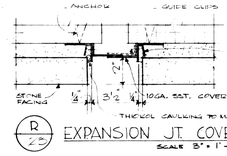

R/23 EXPANSION JT. COVER
SCALE 3" = 1'-0"

J/23 M/23

K/23 N/23 S/23

L/23 P/23 T/23

TYPICAL CONTROL JOINTS
SCALE ¾" = 1'-0"

JAMES WILLIAM KIDENEY No. 2004
PAUL H. HARBACH No. 1908

BUFFALO AND ERIE COUNTY PUBLIC LIBRARY

LAFAYETTE SQUARE BUFFALO NEW YORK

JAMES WILLIAM KIDENEY AND ASSOCIATES
PAUL HYDE HARBACH AND ELON R. CLARK JR.
ASSOCIATED ARCHITECTS
220 DELAWARE AVENUE BUFFALO NEW YORK

C. W. MOHRHARDT AND R. A. ULVELING
ASSOCIATED LIBRARY BUILDING CONSULTANTS

JOB NO 6001
DATE 9-10-60
SCALE AS NOTED
SHEET NO 23

EXTERIOR DETAILS

812-1960-BECL-

12-28-64 As Built Drwg.

Commercial Blue Print Co., Inc., Buffalo