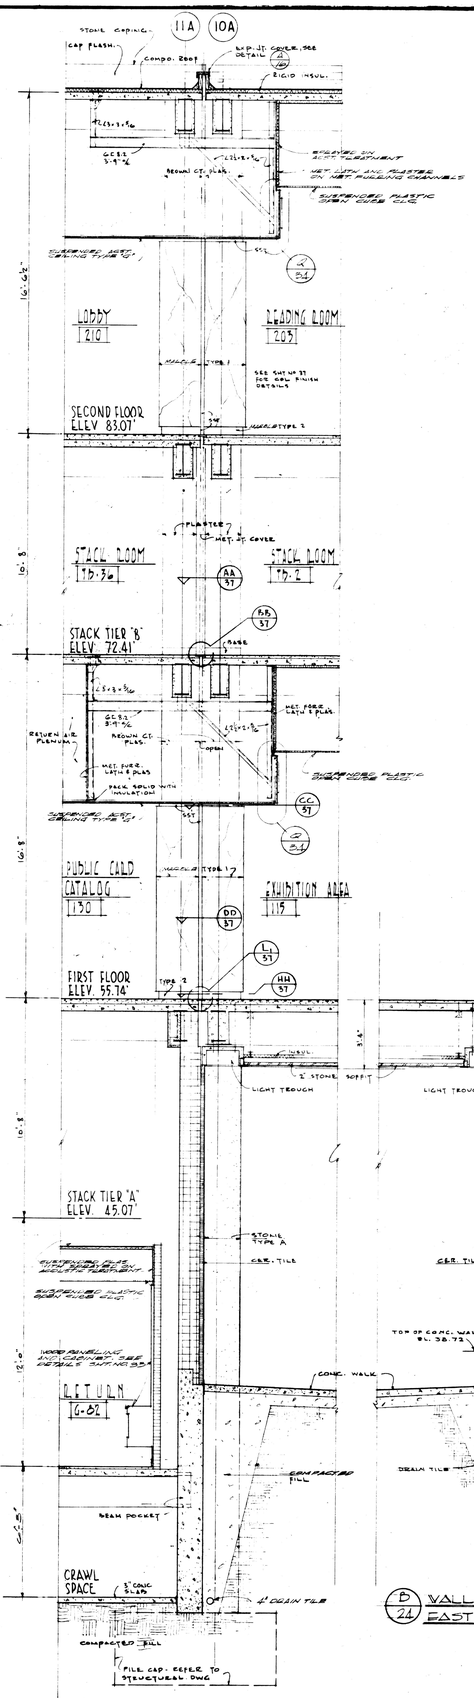

A/24 WALL SECTION THRU EXPANSION JOINT
SCALE: 3/8"=1'-0"

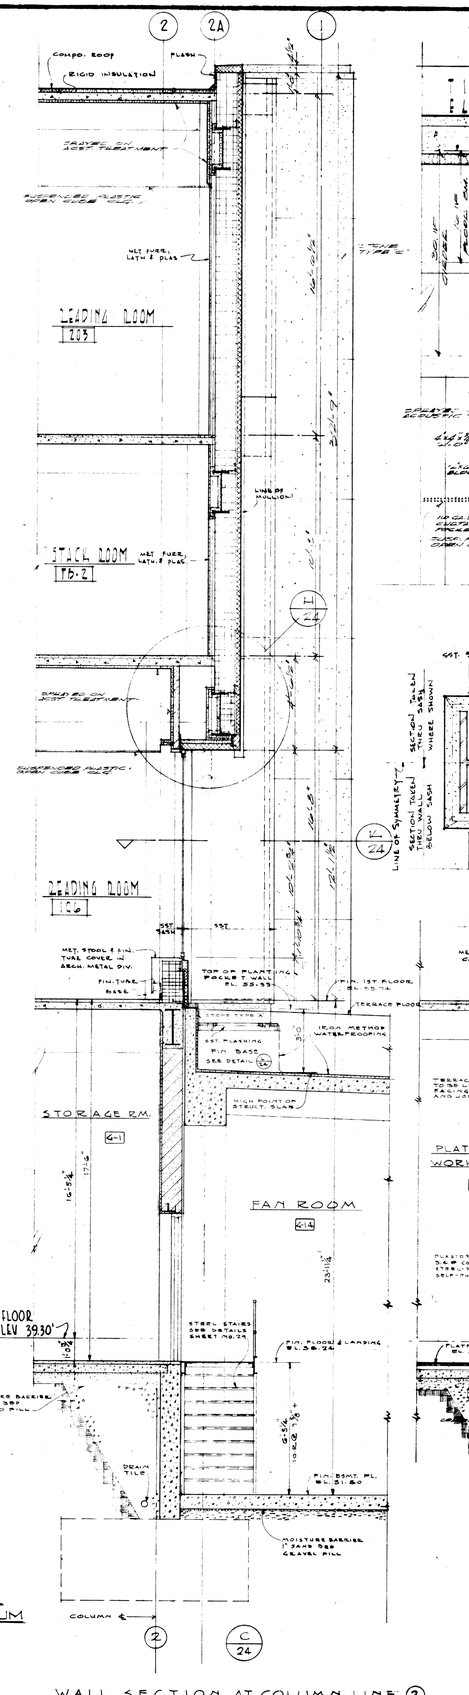

D/24 WALL SECTION THRU EAST WALL OF AUDITORIUM
SCALE: 3/8"=1'-0"

WALL SECTION AT COLUMN LINE (2) THRU PLANTING POCKET & FAN ROOM G-14
SCALE: 3/8"=1'-0"

WALL SECTION AT COLUMN LINE (2) THRU PLANTING POCKET & PASSAGE ROOM G-16
SCALE: 3/8"=1'-0"

TERRACE WALL SECTIONS THRU NORTH ENTRANCE OPNG. G-17 AND LOUVER OPNG. G-18
SCALE: 3/8"=1'-0"

WALL SECTION AT COLUMN LINE (E) THRU PLANTING POCKET & STORAGE ROOM G-13
SCALE: 3/8"=1'-0"

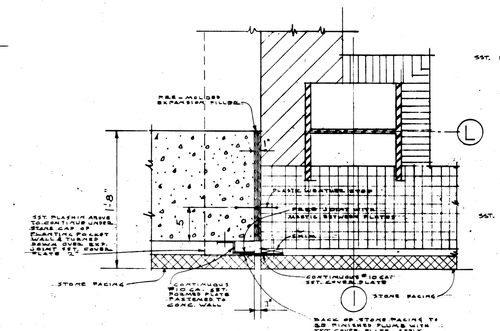

EXPANSION JOINT DETAIL U/24
TERRACE WALL AT MAIN BUILDING
SCALE 1½"=1'-0"
CONDITION SHOWN AT SOUTH WALL

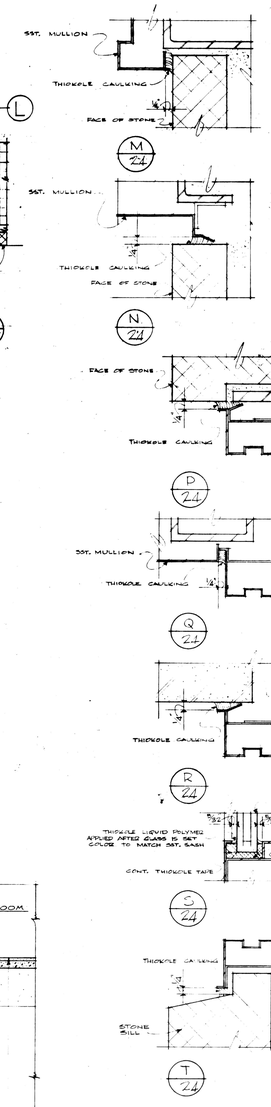

CAULKING DETAILS
SCALE ½ FULL SIZE

BUFFALO AND ERIE COUNTY PUBLIC LIBRARY
LAFAYETTE SQUARE BUFFALO NEW YORK

JAMES WILLIAM KIDENEY AND ASSOCIATES
PAUL HYDE HARBACH AND ELON B CLARK JR
ASSOCIATED ARCHITECTS
220 DELAWARE AVENUE BUFFALO NEW YORK
C. M. MOHRHARDT AND R. A. ULVELING
ASSOCIATED LIBRARY BUILDING CONSULTANTS

JOB NO. 6001 SHEET NO. 24
DATE 9-19-60
SCALE AS NOTED

EXTERIOR DETAILS

12-28-64 AS BUILT DWGS.

812-1960-BECLT

COMMERCIAL BLUE PRINT CO., INC., BUFFALO

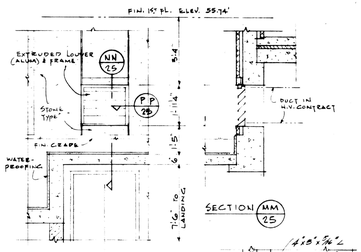

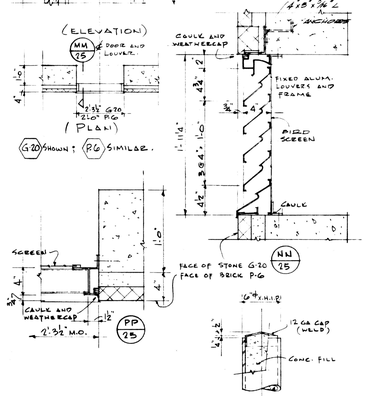

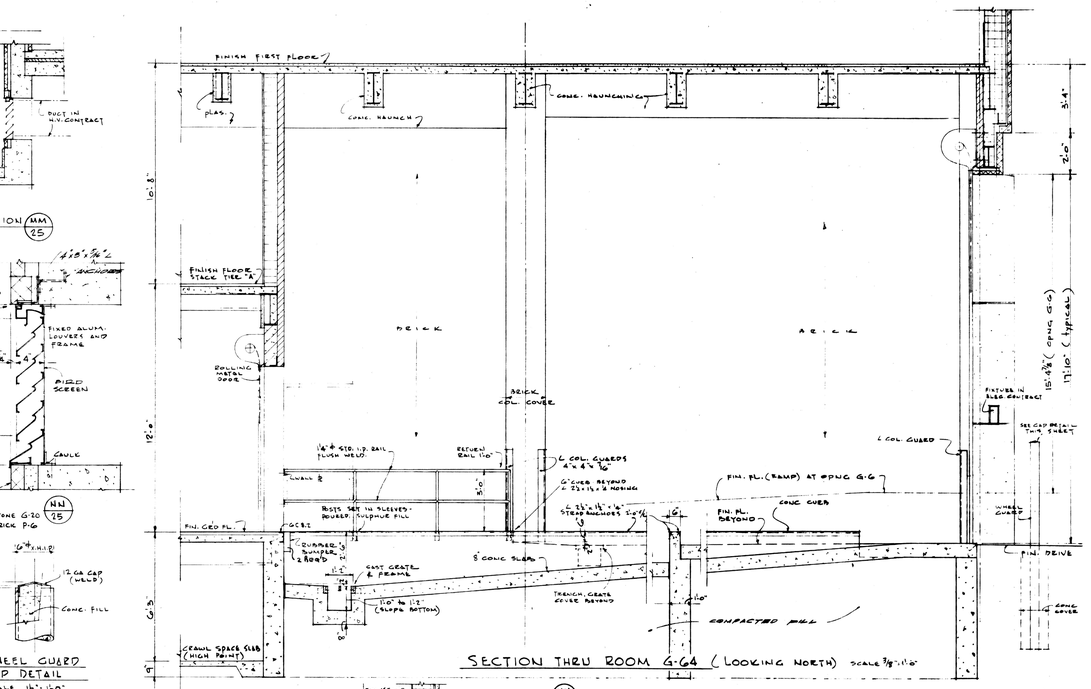

SECTION THRU ROOM G-64 (LOOKING NORTH) SCALE ⅜"=1'-0"

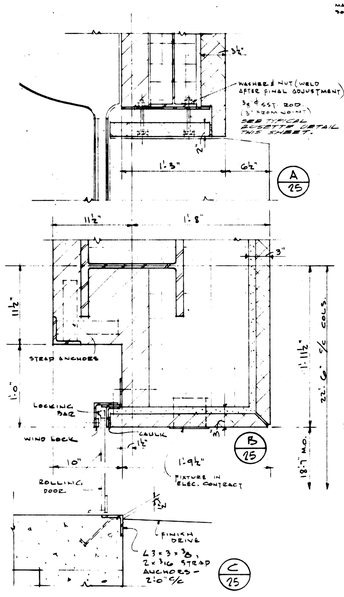

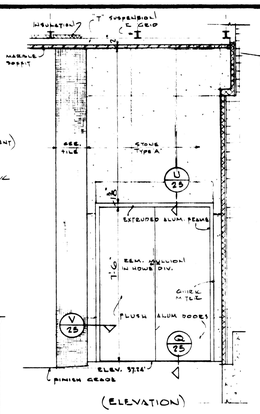

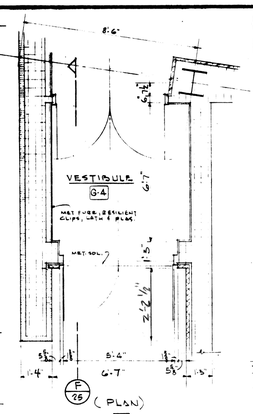

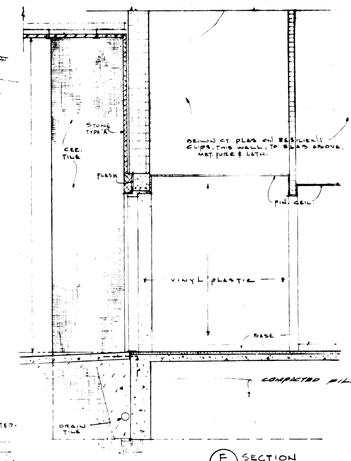

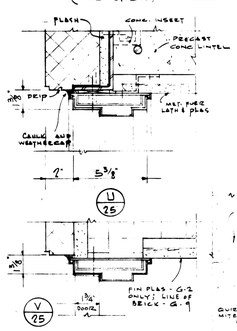

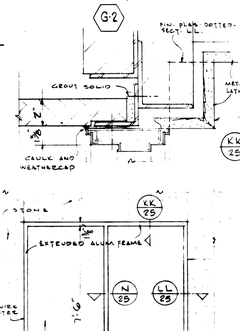

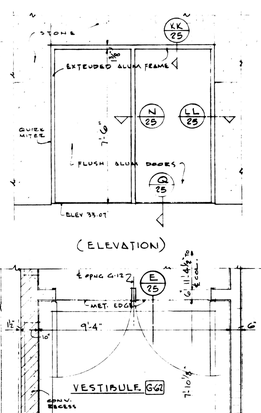

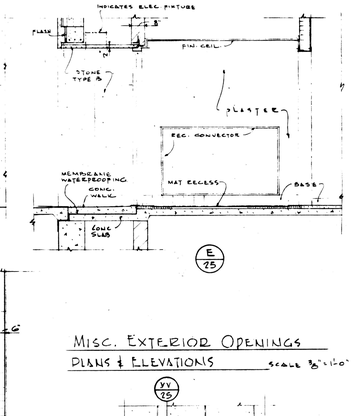

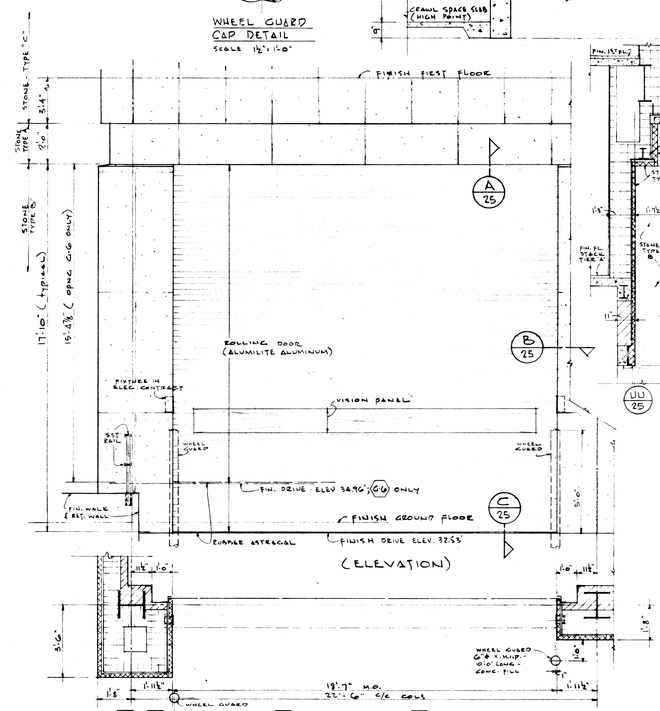

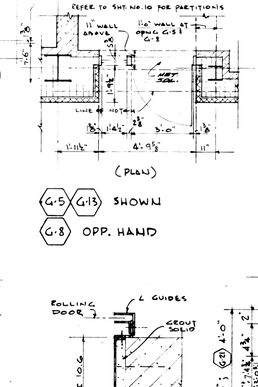

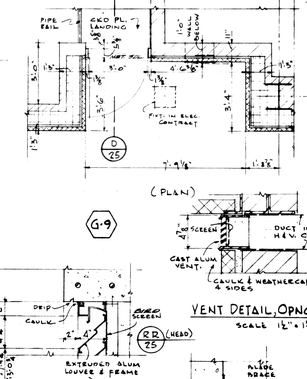

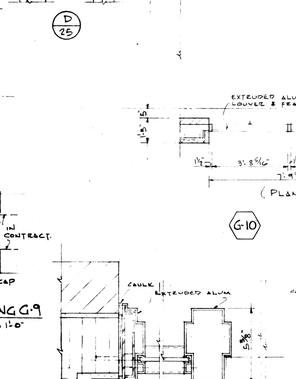

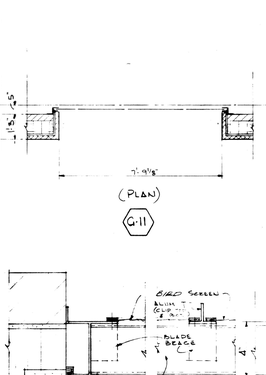

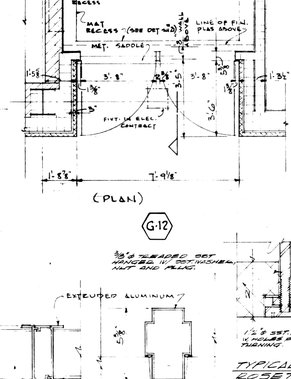

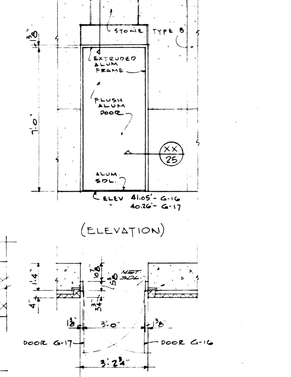

MISC. EXTERIOR OPENINGS PLANS & ELEVATIONS

SCALE ⅜"=1'-0"

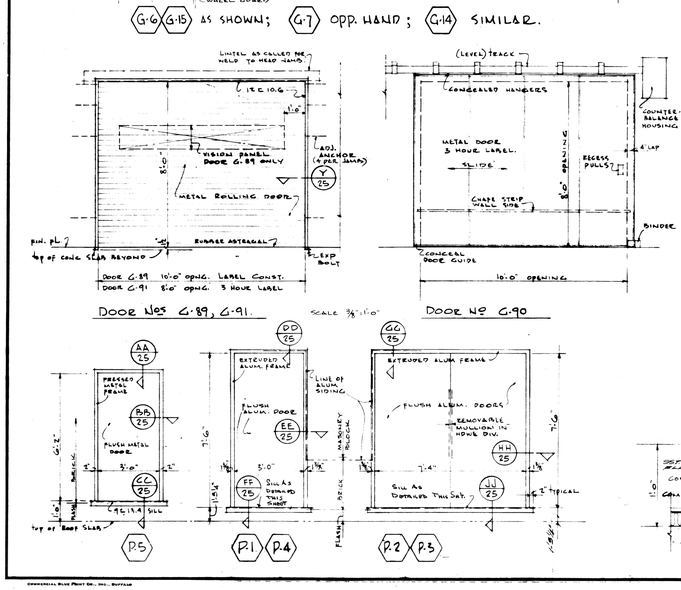

Door Nos G-89, G-91. SCALE ⅜"=1'-0" Door No G-90

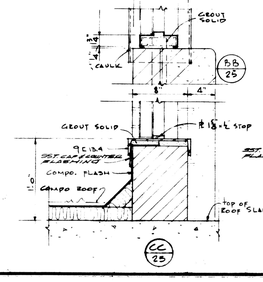

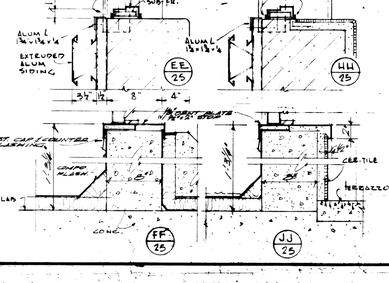

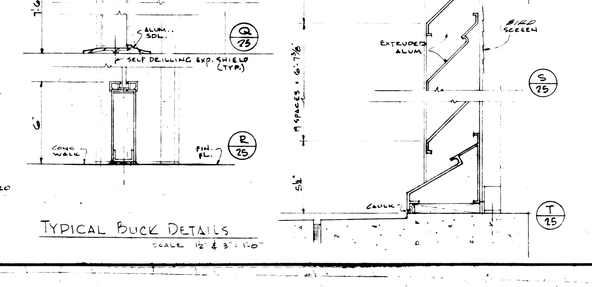

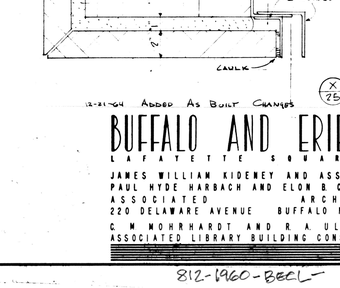

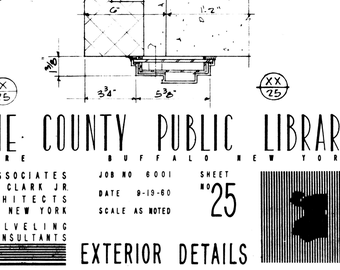

BUFFALO AND ERIE COUNTY PUBLIC LIBRARY
LAFAYETTE SQUARE BUFFALO NEW YORK
JAMES WILLIAM KIDENEY AND ASSOCIATES
PAUL HYDE HARBACH AND ELON B. CLARK JR.
ASSOCIATED ARCHITECTS
220 DELAWARE AVENUE BUFFALO NEW YORK
C. W. MOHRHARDT AND R. A. ULVELING
ASSOCIATED LIBRARY BUILDING CONSULTANTS

JOB NO 6001
DATE 9-19-60
SCALE AS NOTED
SHEET NO 25

EXTERIOR DETAILS

12-28-64 As Built Dwgs.

812-1960-BECL

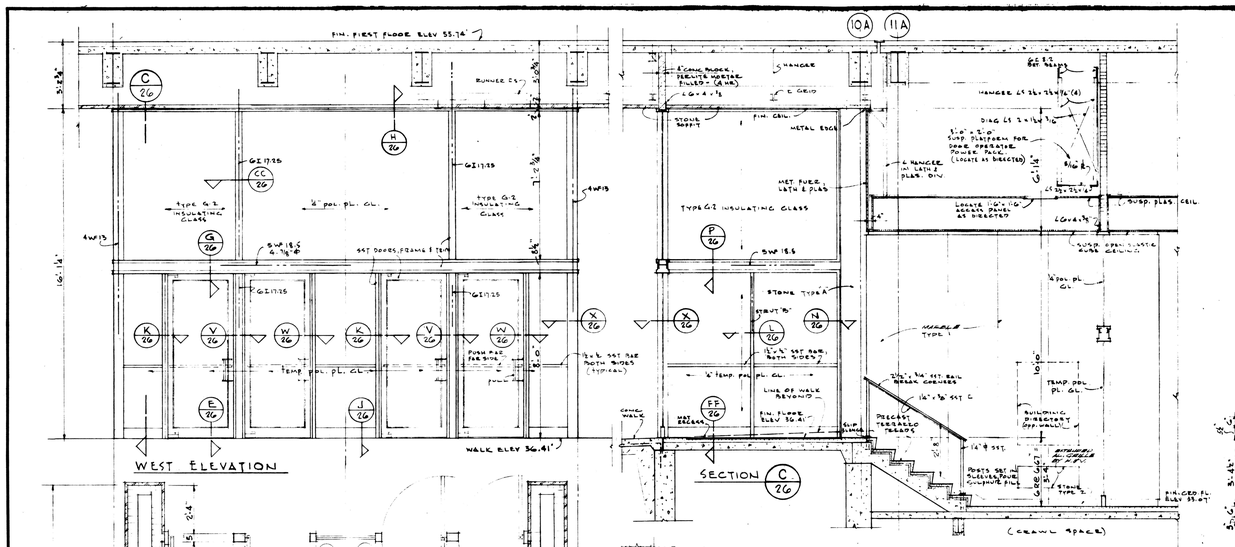

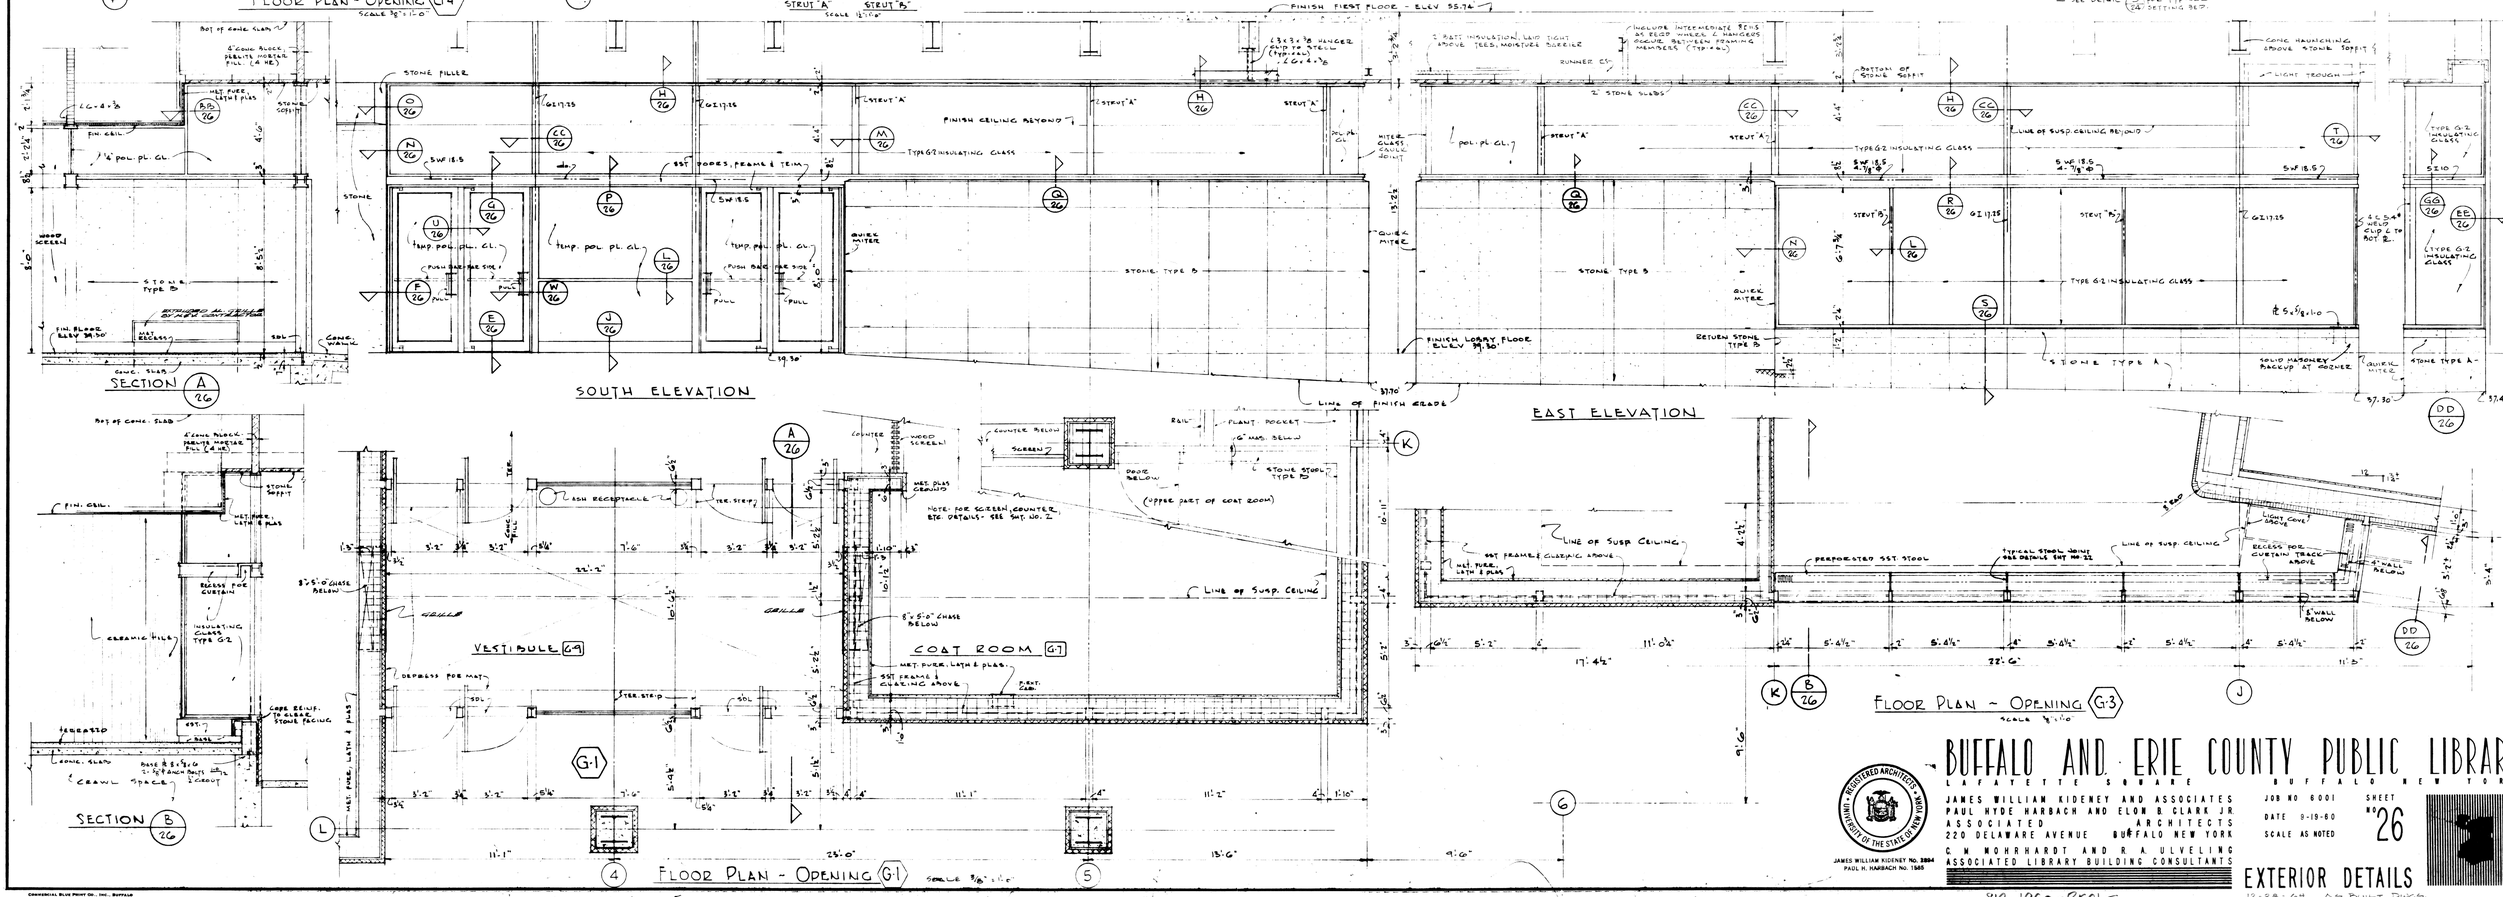

BUFFALO AND ERIE COUNTY PUBLIC LIBRARY
LAFAYETTE SQUARE BUFFALO NEW YORK
JAMES WILLIAM KIDENEY AND ASSOCIATES
PAUL HYDE HARBACH AND ELON B. CLARK JR.
ASSOCIATED ARCHITECTS
220 DELAWARE AVENUE BUFFALO NEW YORK
C. W. MOHRHARDT AND R. A. ULVELING
ASSOCIATED LIBRARY BUILDING CONSULTANTS
JAMES WILLIAM KIDENEY NO. 2804
PAUL H. HARBACH NO. 1585

JOB NO 6001
DATE 9-19-60
SCALE AS NOTED
SHEET NO 26

EXTERIOR DETAILS

12-28-64 As Built Dwgs.

812-1960-BECL

COMMERCIAL BLUE PRINT CO., INC., BUFFALO