ADDENDUM NO. 1

COUNTY OF ERIE
DEPARTMENT OF ENVIRONMENT AND PLANNING
ERIE COUNTY SEWER DISTRICT NO. 1
CONTRACT NO. 52
FRENCH ROAD AT RANDY WAY SEWER REPLACEMENT

All bidders must **fax** or **e-mail** this sheet to Erie County Department of Environment and Planning/Division of Sewerage Management (Attn: Beth Pfalzer), to fax no. 716-858-6257 or e-mail dsm@erie.gov. By signing and dating this sheet bidders are stating that their company has received Addendum No. 1 to the Erie County Sewer District No. 1; Contract No. 52; French Road at Randy Way Sewer Replacement.

Received: _____

By: _____

Phone: _____

Date: _____

All bidders must incorporate Addendum No. 1 including all attachments when submitting bids for this contract. Bidders are also advised to acknowledge Addendum No. 1 in the Receipt of Addenda section 7.03 of the Bid Form and endorse the special notice page attached hereto and made part of Addendum No. 1. This Addendum consists of 1 page and attachments, if any, listed on the last page.

IF YOU RECEIVED THIS ADDENDUM IN ERROR, OR WOULD LIKE TO BE REMOVED FROM THE POTENTIAL BIDDER LIST FOR THE REFERENCED PROJECT (AND NOT RECEIVE FURTHER CORRESPONDENCE REGARDING THIS PROJECT), PLEASE CONTACT dsm@erie.gov OR CALL THE DSM OFFICE AT 716-858-8383.

Erie County Sewer District No. 1
French Road at Randy Way Sewer Replacement
Contract No. 52

ADDENDUM No. 1

Additions and Modifications

BIDDING REQUIREMENTS SPECIFICATIONS:

1. **Document 00 11 13, Advertisement for Bids**: Replace the first sentence of the second paragraph with the following: "*Bids will be received by the Commissioner of the Erie County Department of Environment and Planning located at 95 Franklin Street, Room 1034, Buffalo, New York 14202, until* ***November 24, 2026 at 2:00 pm*** *local time."*

2. **Instructions to Bidders, Section 00 21 13 – 5.03 Other Site-related Documents, A. 1. – Add** "*b. French Road Trunk, East of Union Rd, STA 84+00 to STA 98+0; Sheet No. 46; Nussbaumer, Clark, & Velzy Consulting Engineers, dated October 1960.* "

ATTACHMENTS

1. Record Plans - French Road Trunk, East of Union Rd, STA 84+00 to STA 98+0; Sheet No. 46; Nussbaumer, Clark, & Velzy Consulting Engineers, October 1960

End of Addendum

FRENCH ROAD

(COUNTY HWY.)

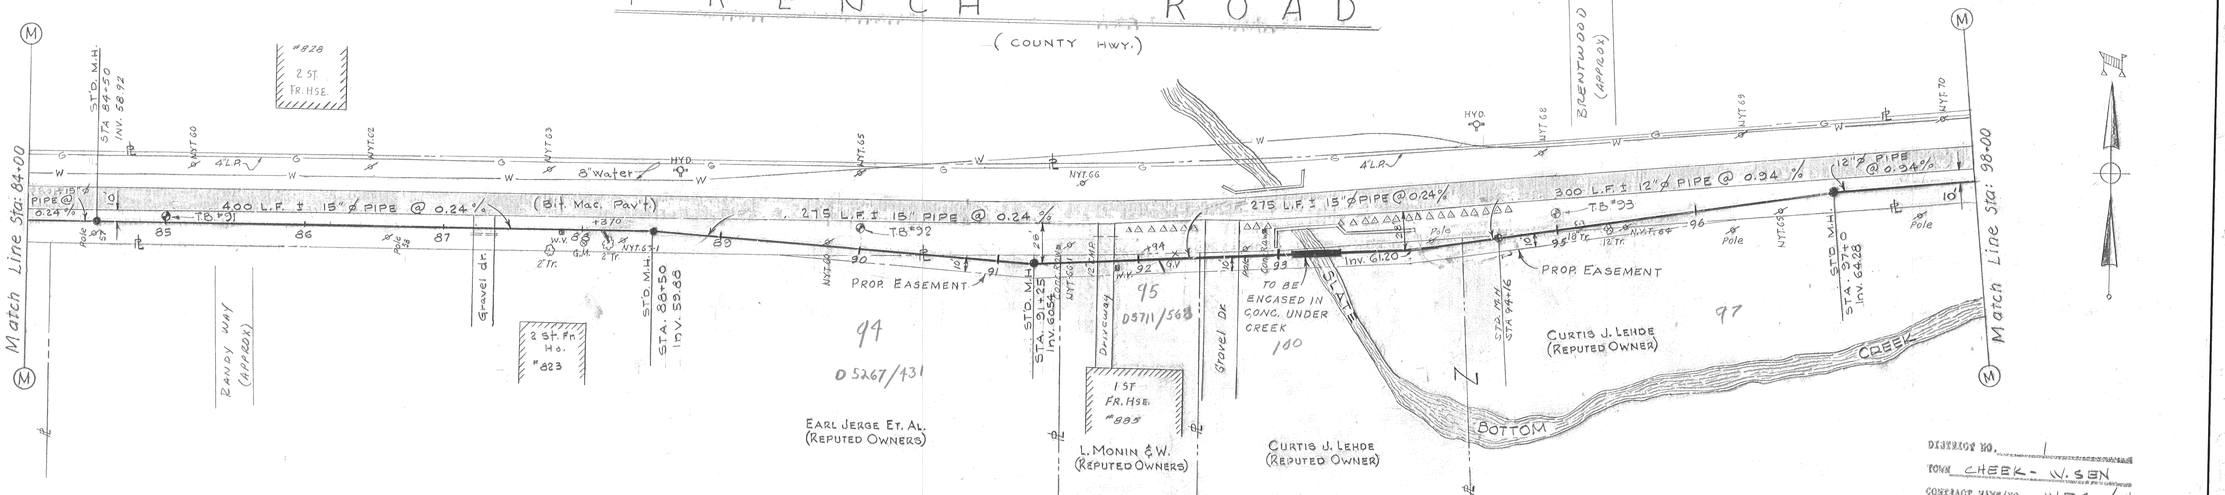

PLAN

Scale: 1" = 50'

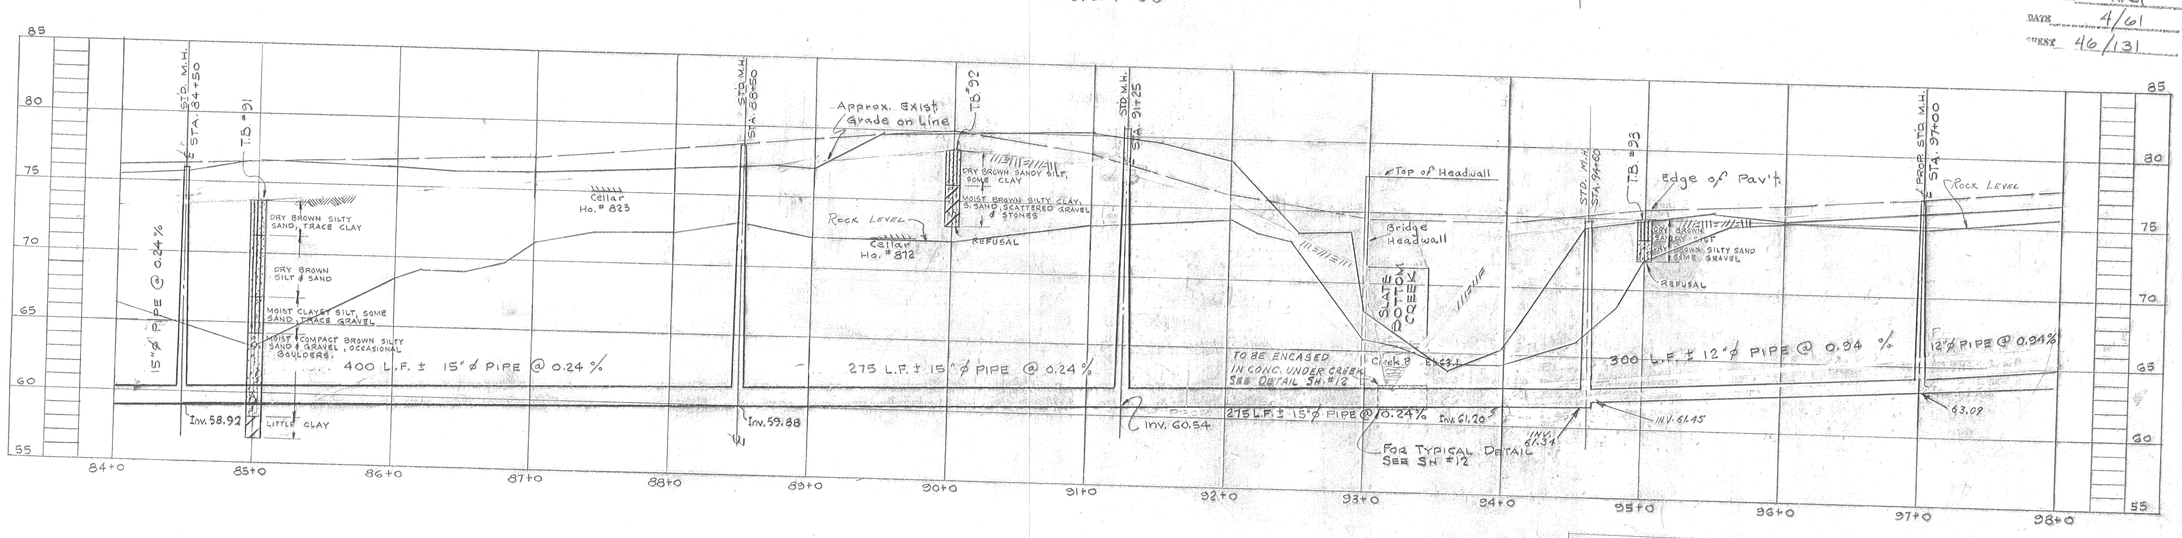

PROFILE

Scale: Vert: 1" = 5'
Horz: 1" = 50'

SCALE: 1"=50'

NOTES:

(1) Exact location of existing utilities unknown. To be located in field by Contractor before construction.

(2) Elevations shown are based on City of Buffalo Datum. To convert to U.S.G.S. Datum as per:
(A) City of Buffalo, add 575.45
(B) New York State D.P.W. add 575.07

T.B. #'s = Test Boring # Number

DISTRICT NO. 1
TOWN CHEEK-W.SEN
CONTRACT NAME/NO. INPC/46
TYPE INT
STATUS AS BUILT
ENGINEER NCL
DATE 4/61
SHEET 46/131

ERIE COUNTY, NEW YORK
SANITARY SEWER DISTRICT No. 1
CHEEKTOWAGA - WEST SENECA

FRENCH RD. TRUNK
EAST OF UNION RD.
STA. 84+0 TO STA. 98+0

NUSSBAUMER, CLARKE & VELZY
CONSULTING ENGINEERS
BUFFALO, N. Y. NEW YORK, N. Y.

DRAWN BY PG	REV. 4-24-61	SHEET No. 46
DATE OCT. 1960	JOB No. NC 1713	
SCALE As Shown	DWG. No. C 6145-46	

AS BUILT - COMPLETE

BULLIVAN-MCKEEHAN CO. INC., BUFFALO. NO. N-166 CLOTH 8-60-200